




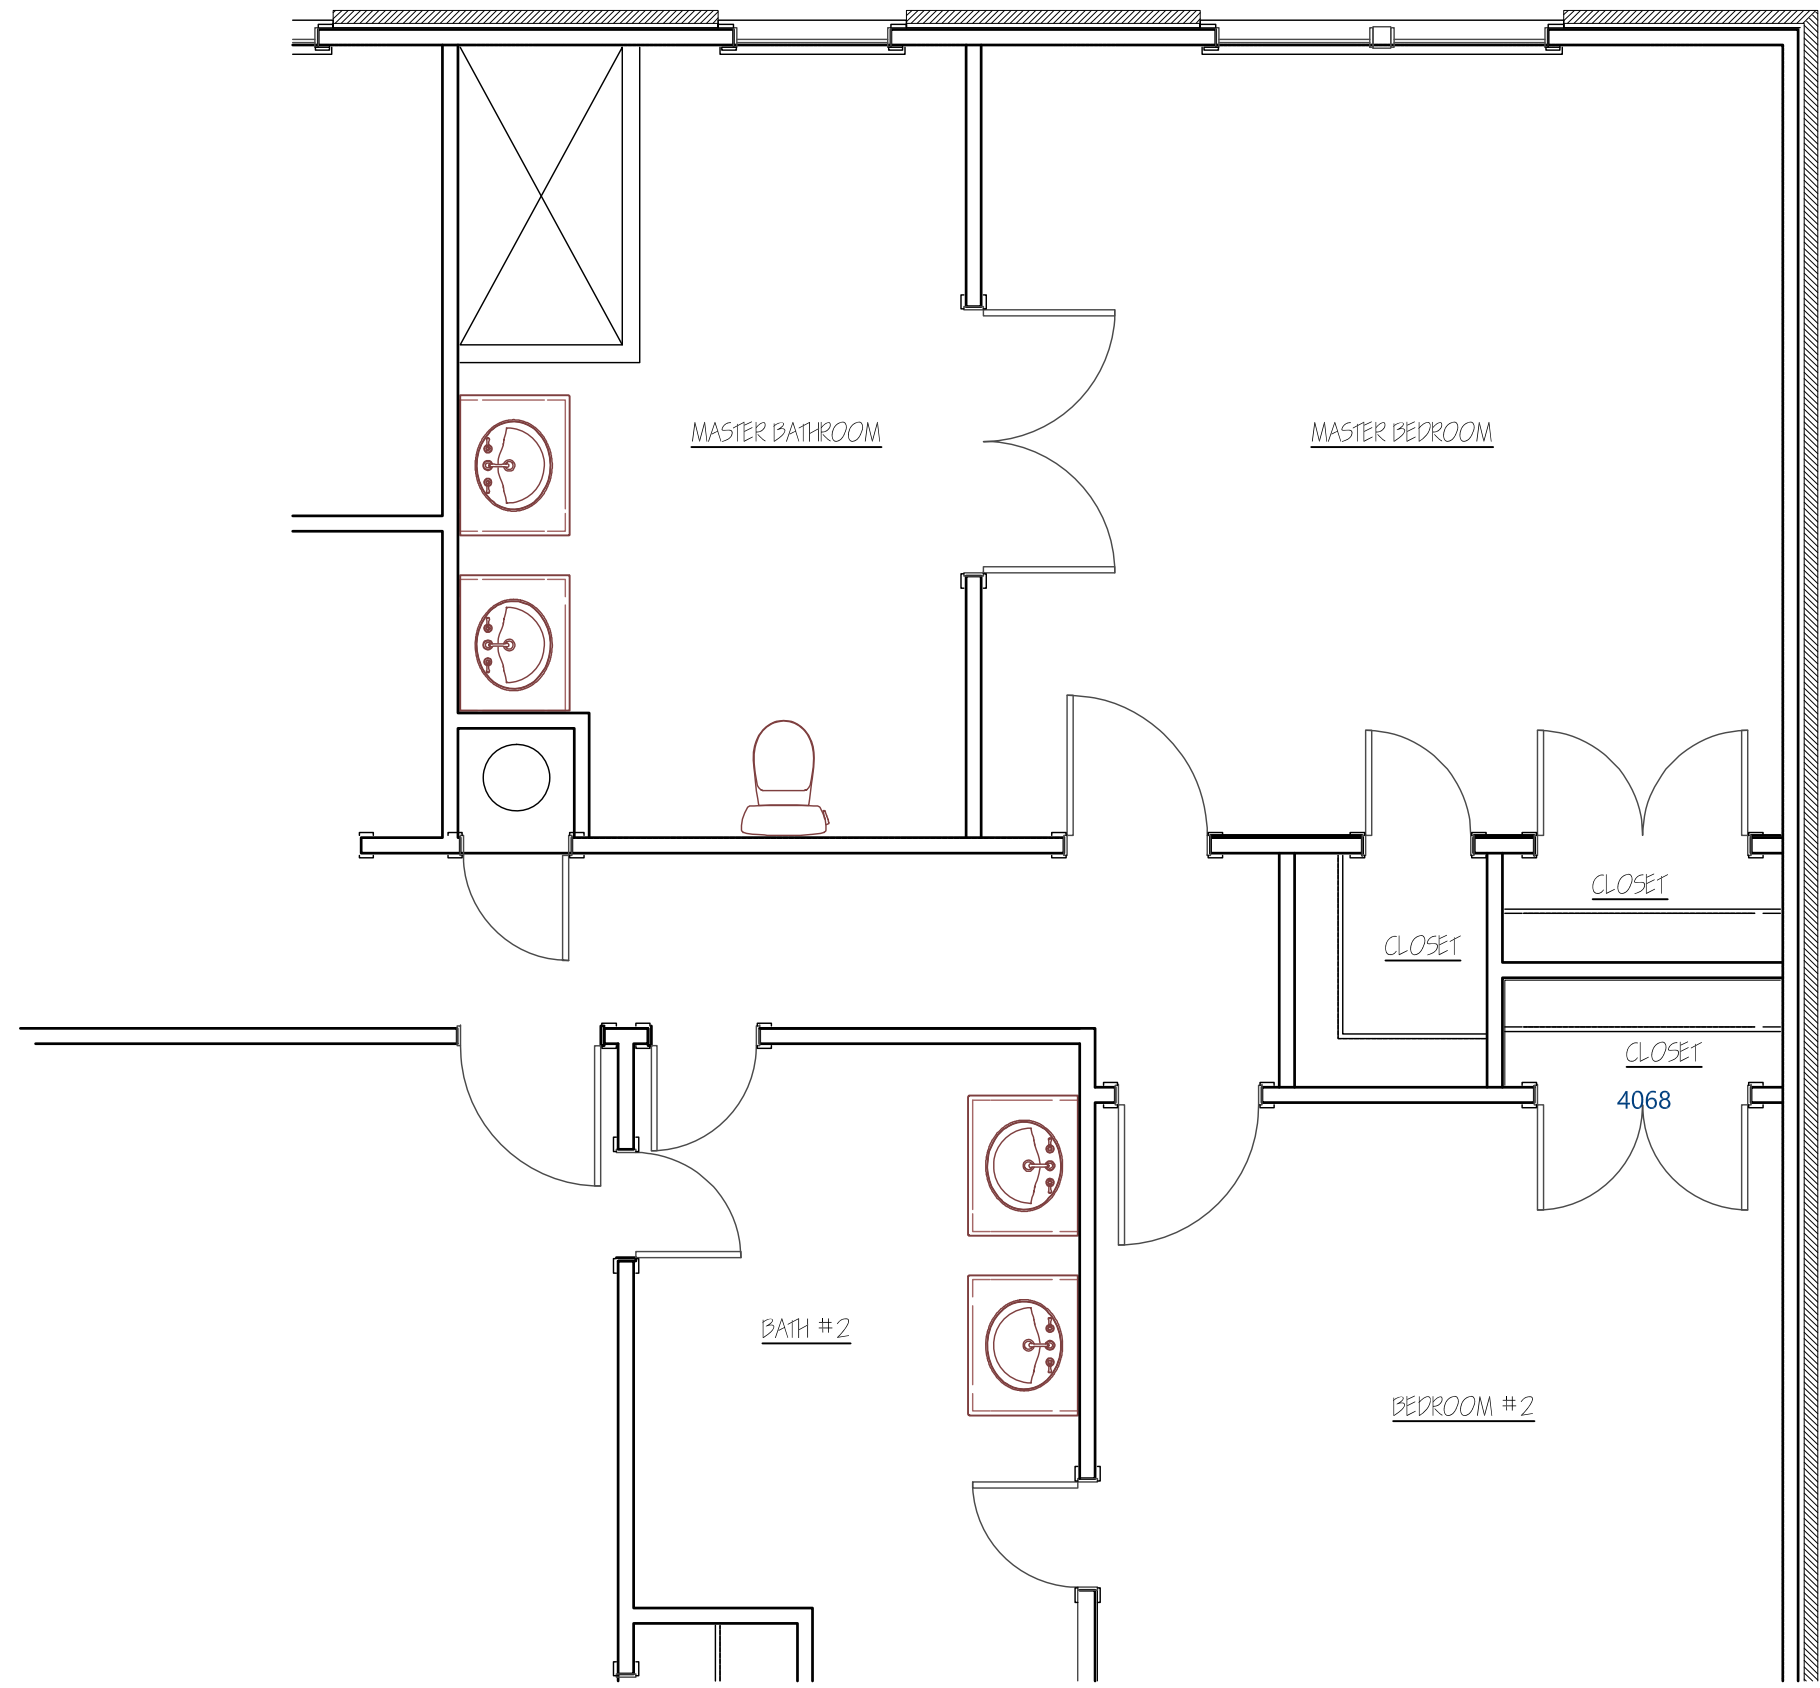

1
1 AS-BUILT 1ST FLOOR
Scale 1/4" = 1'-0"

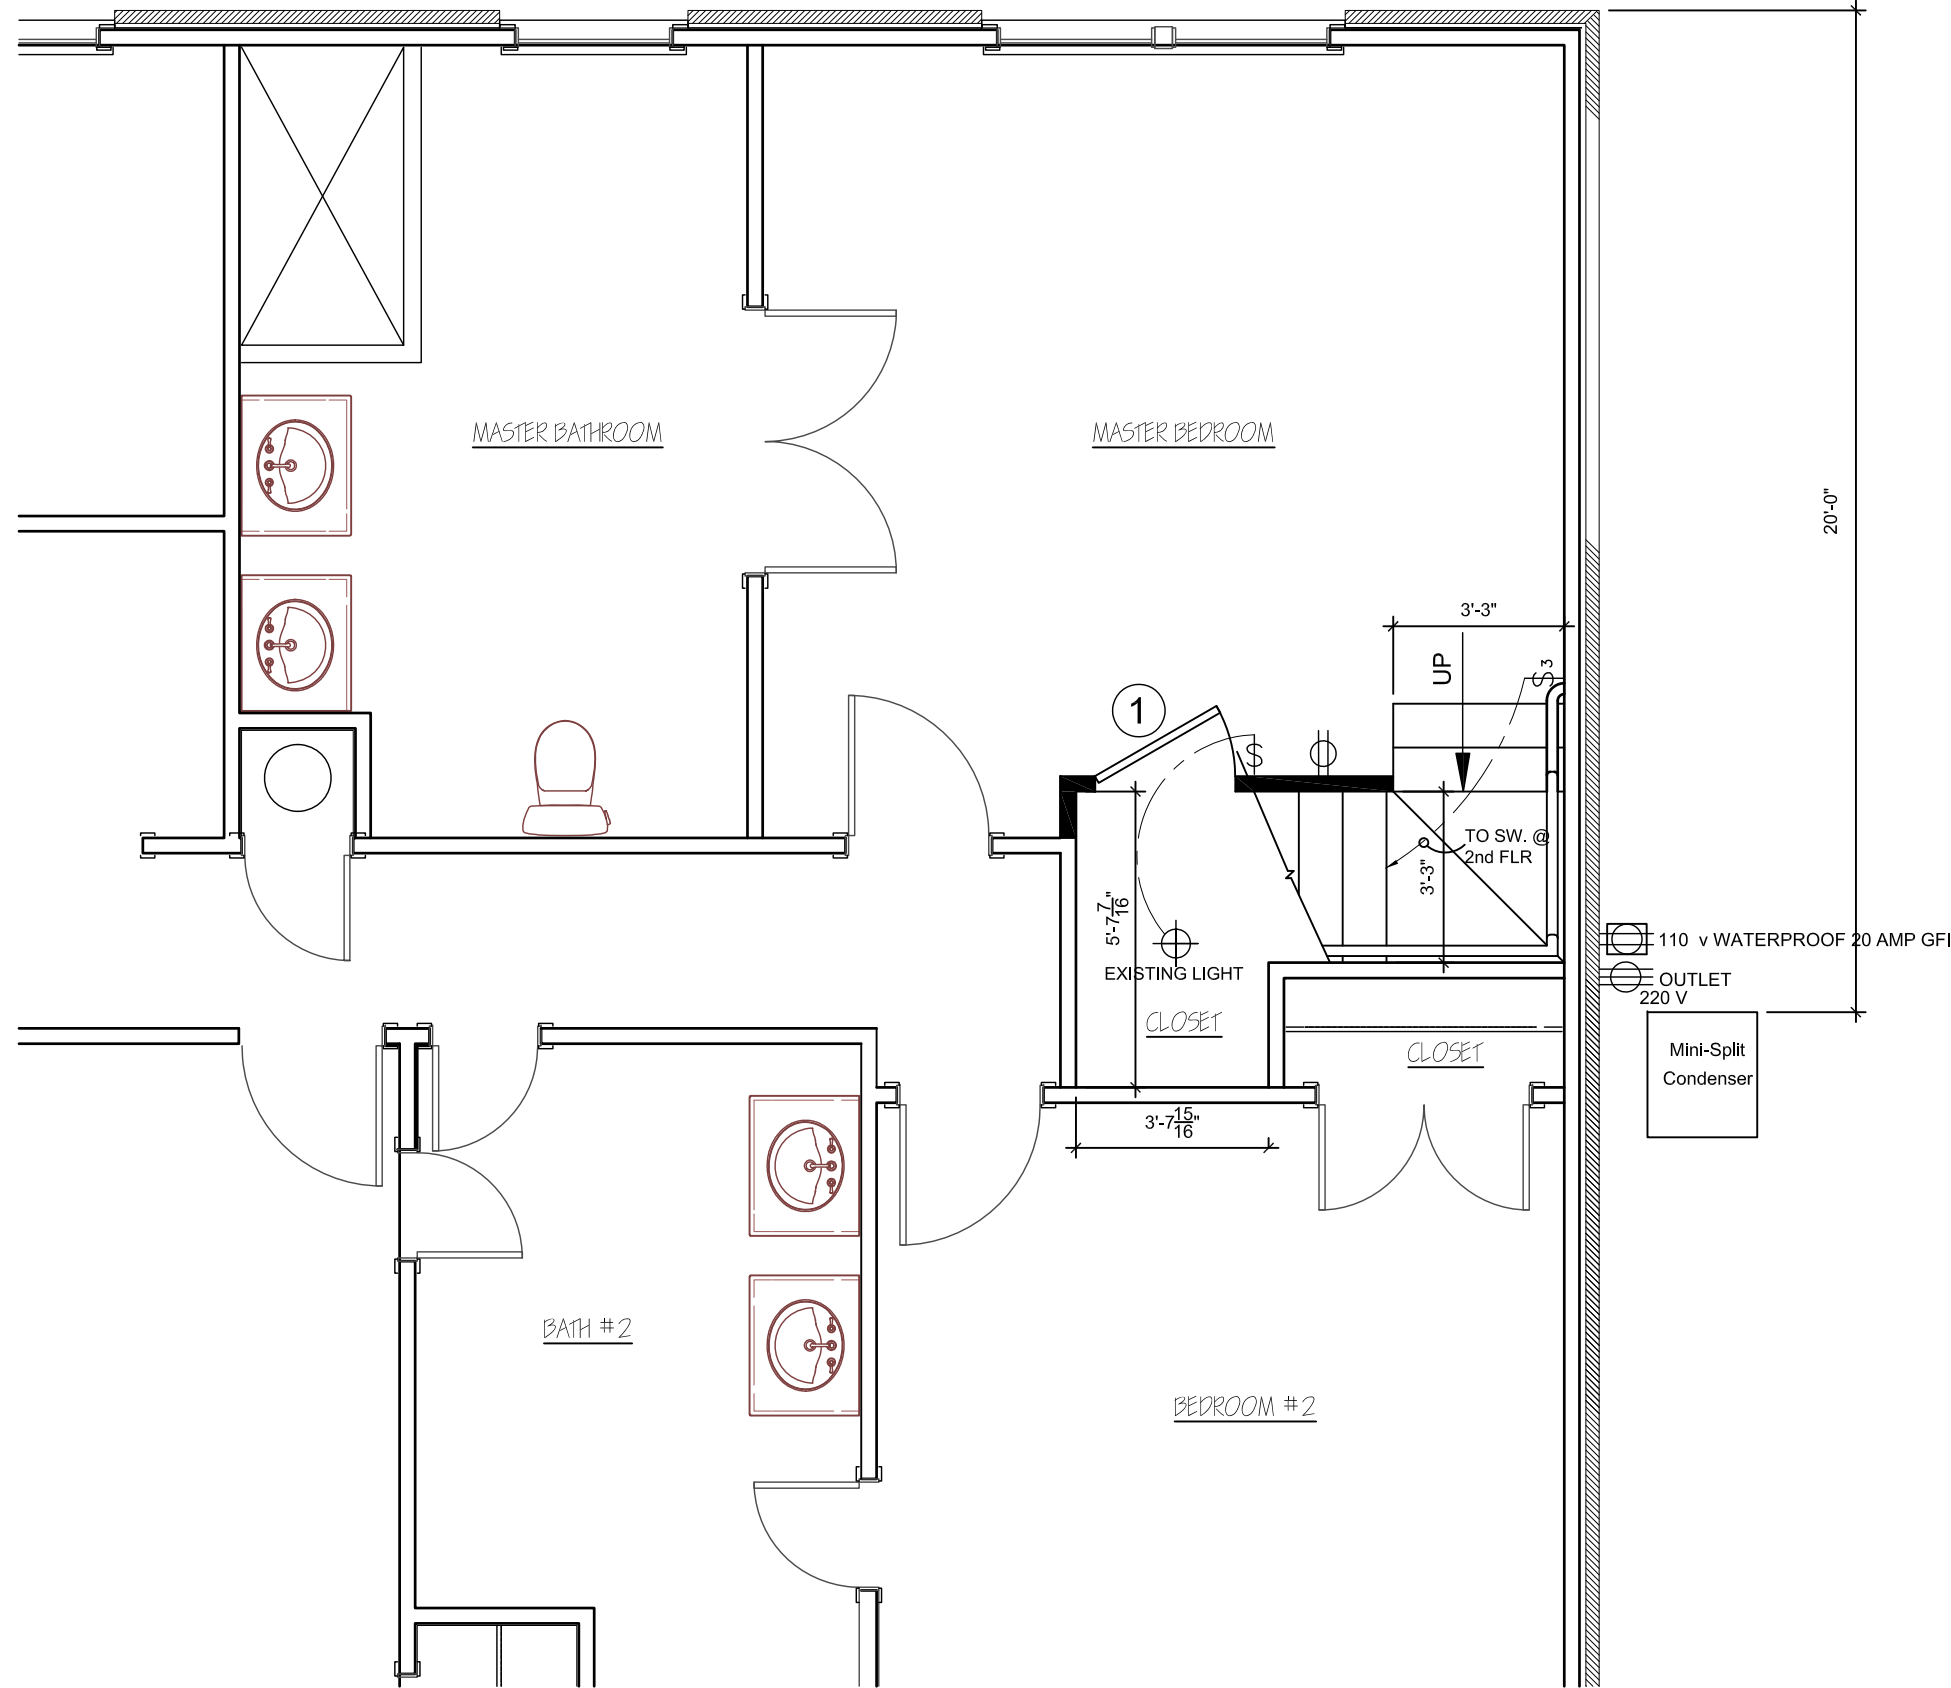


2
1 PROPOSED 1ST FLOOR
Scale 1/4" = 1'-0"

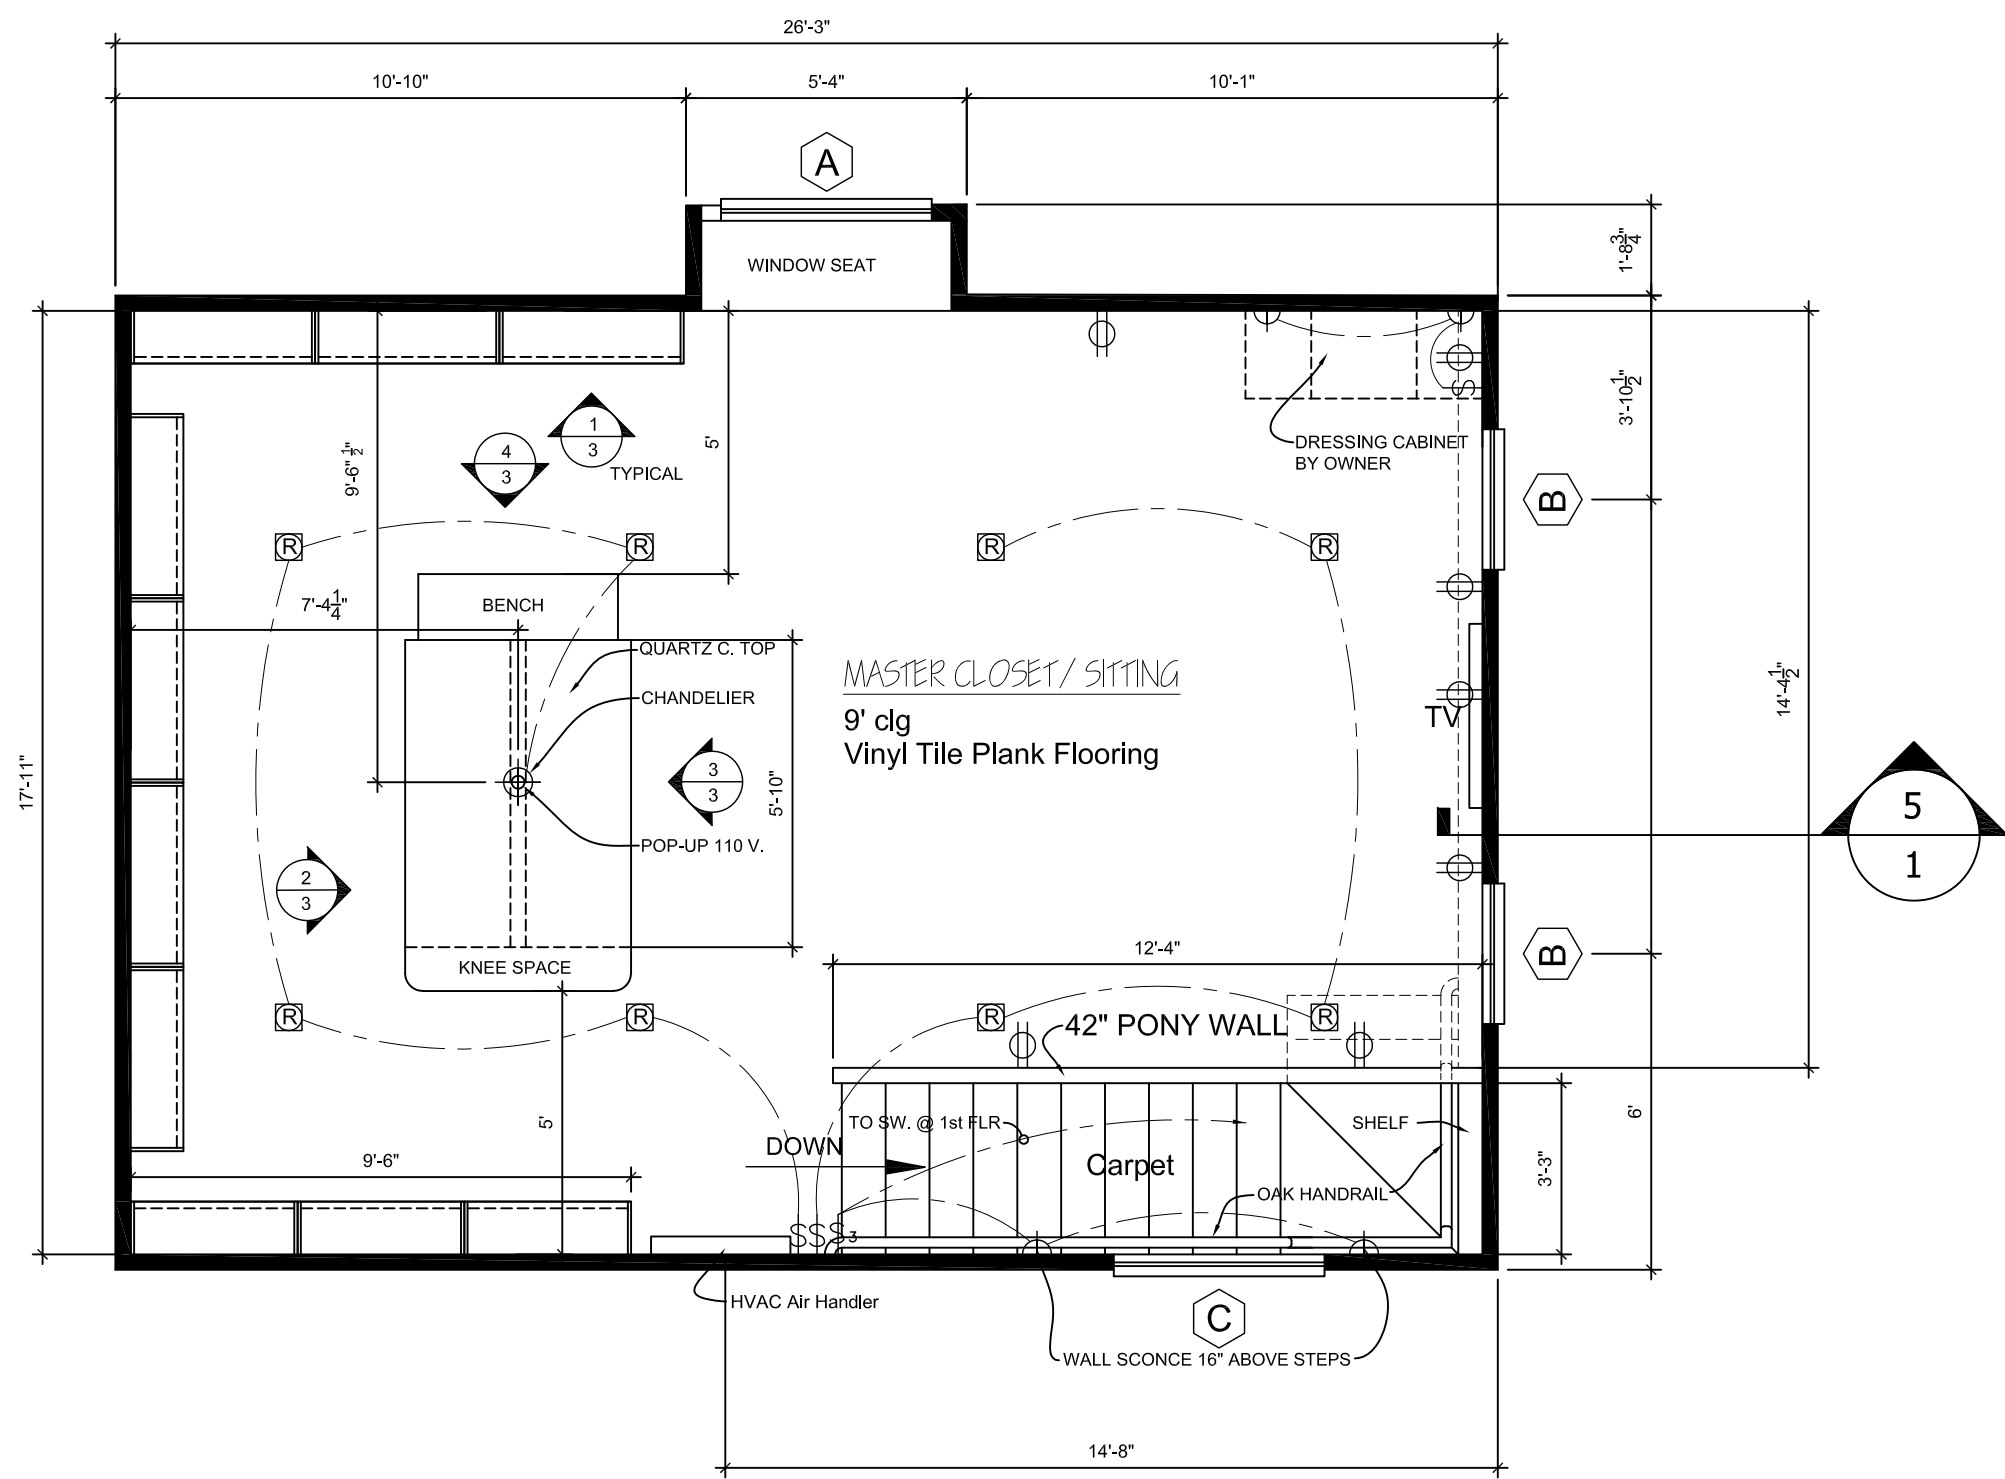

3
1 PROPOSED 2ND FLOOR
Scale 1/4" = 1'-0"


EXISTING WALLS
NEW WALLS
WALLS TO BE REMOVED

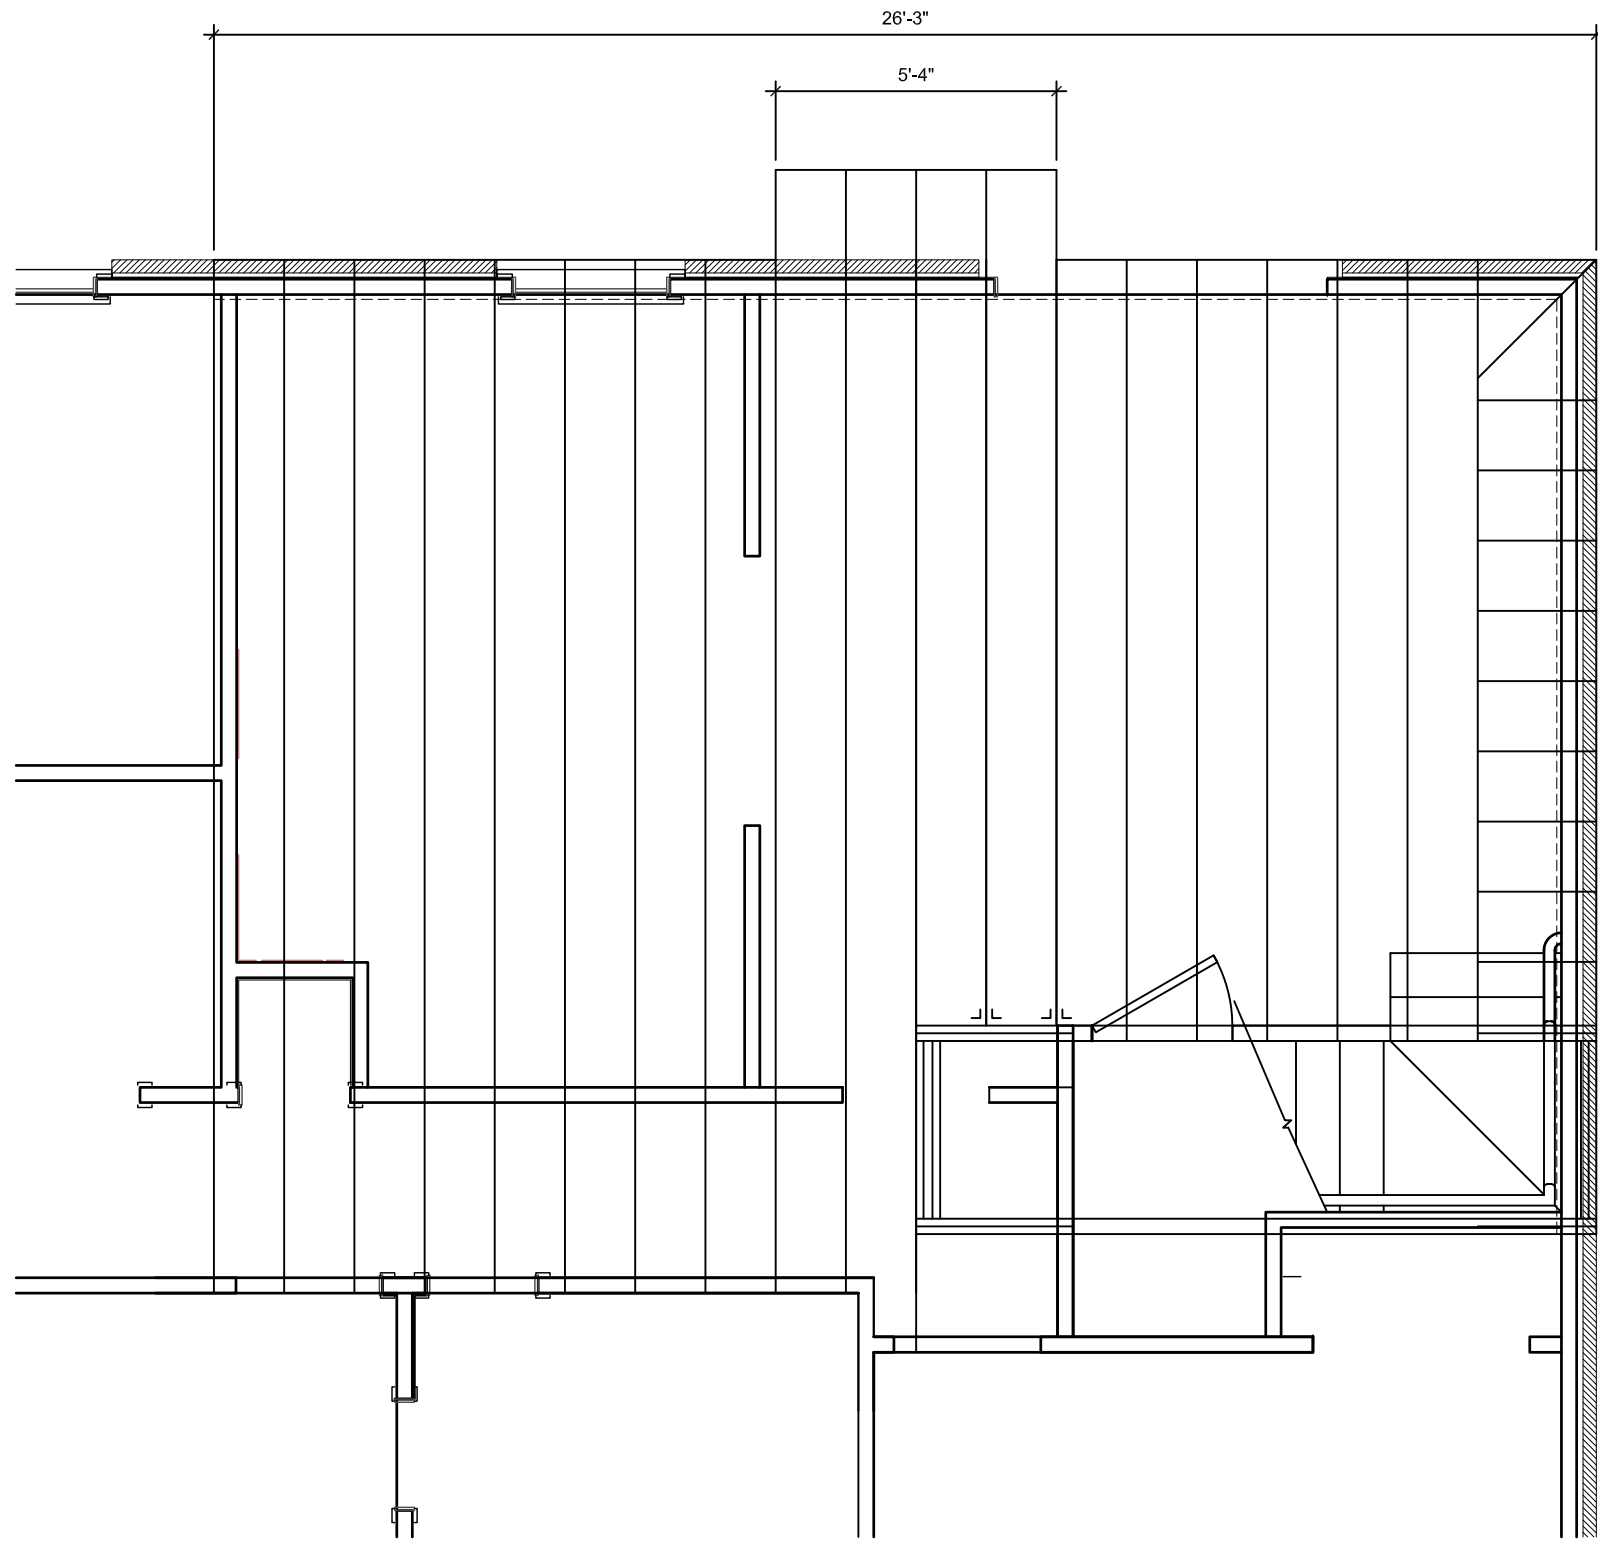

4
1 PROPOSED FLOOR FRAMING
OVERLAYED ON 1ST FLOOR
Scale 1/4" = 1'-0"

WINDOW SCHEDULE					
MARK	COLOR	Wth	HT	DESCRIPTION	
A	WHITE	4 ⁰	4 ⁶	P/W, VINYL, I. G., LOW - E, ARGON	
B	WHITE	2 ⁸	5 ⁰	S/H, VINYL, I. G., LOW - E, ARGON	
C	WHITE	4 ⁰	4 ⁶	P/W, VINYL, I. G., LOW - E, ARGON	

DOOR SCHEDULE				
MARK	THK	Wth	HT	DESCRIPTION
1	1-3/8	2 ⁰	6 ⁸	MOVE EXISTING

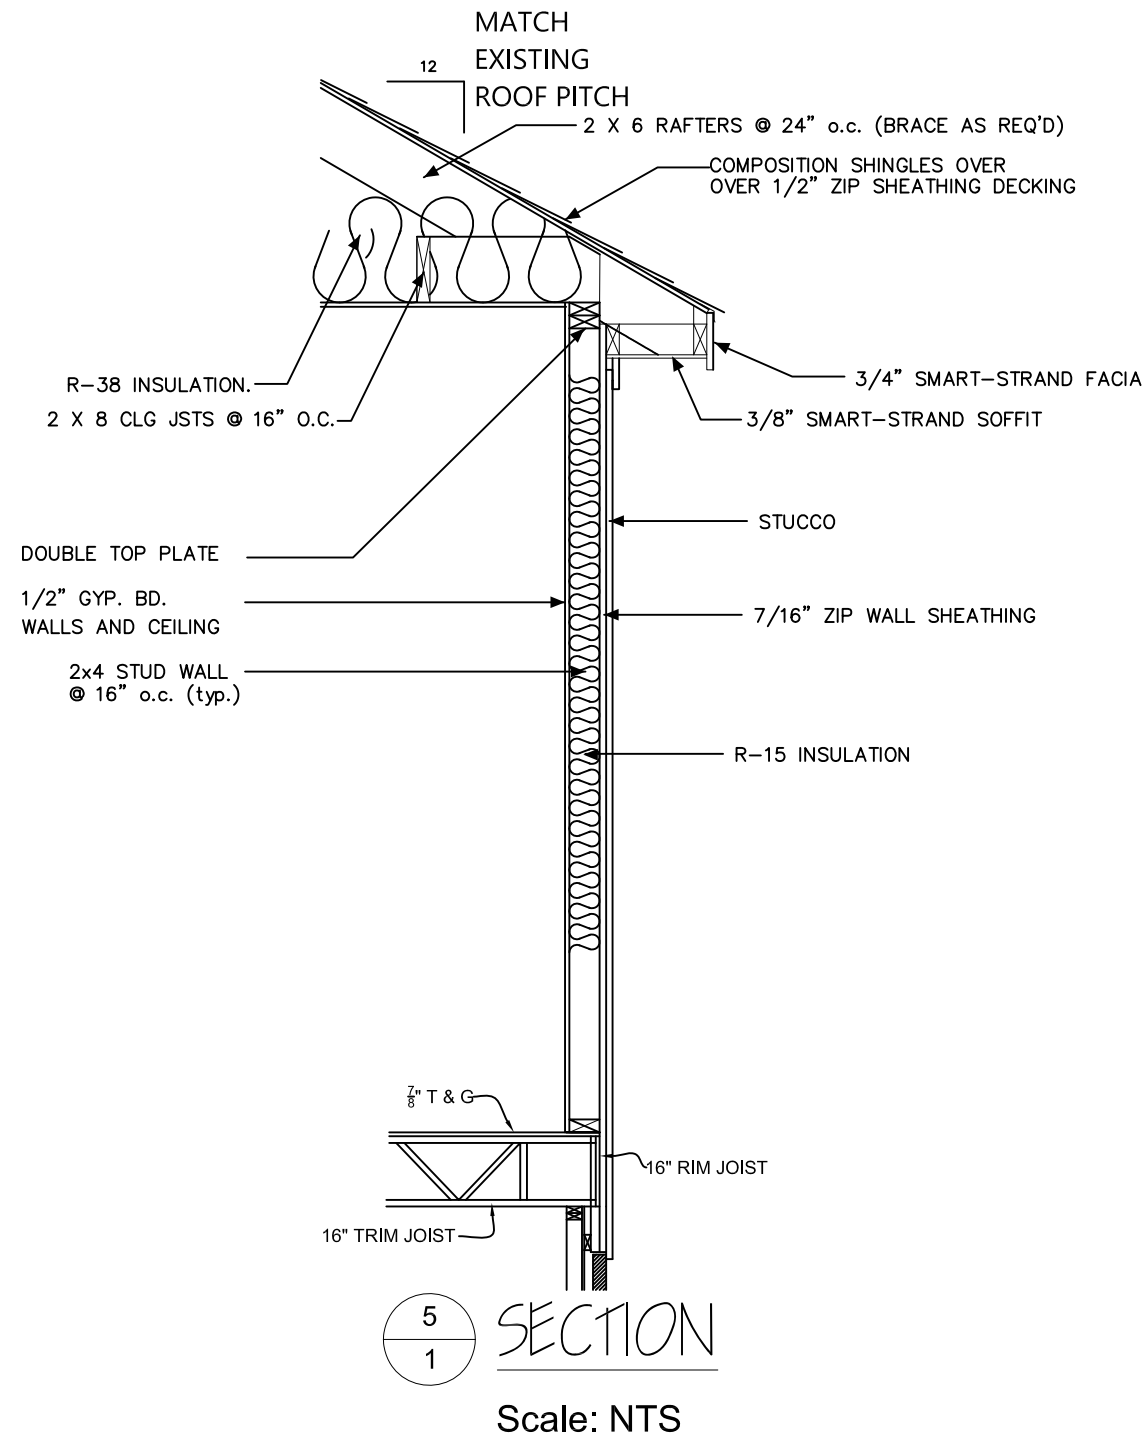

THIS DRAWING AND ALL INFORMATION THEREON IS THE PROPRIETARY PROPERTY OF TREND BUILDERS AND MUST NOT BE MADE PUBLIC OR COPIED. THIS DRAWING IS LOANED SUBJECT TO RETURN ON DEMAND AND IS NOT TO BE USED, DIRECTLY OR INDIRECTLY, IN ANY WAY DETRIMENTAL TO THE INTEREST OF TREND BUILDERS.

REVISIONS

No. 4

Date 00/00/00

Description

PROJECT: 2nd Floor Addition


CUSTOMER:

DATE: 10/23/20


SHEET: 1 OF 3

DRAWING: Floor Plan Roof Plan




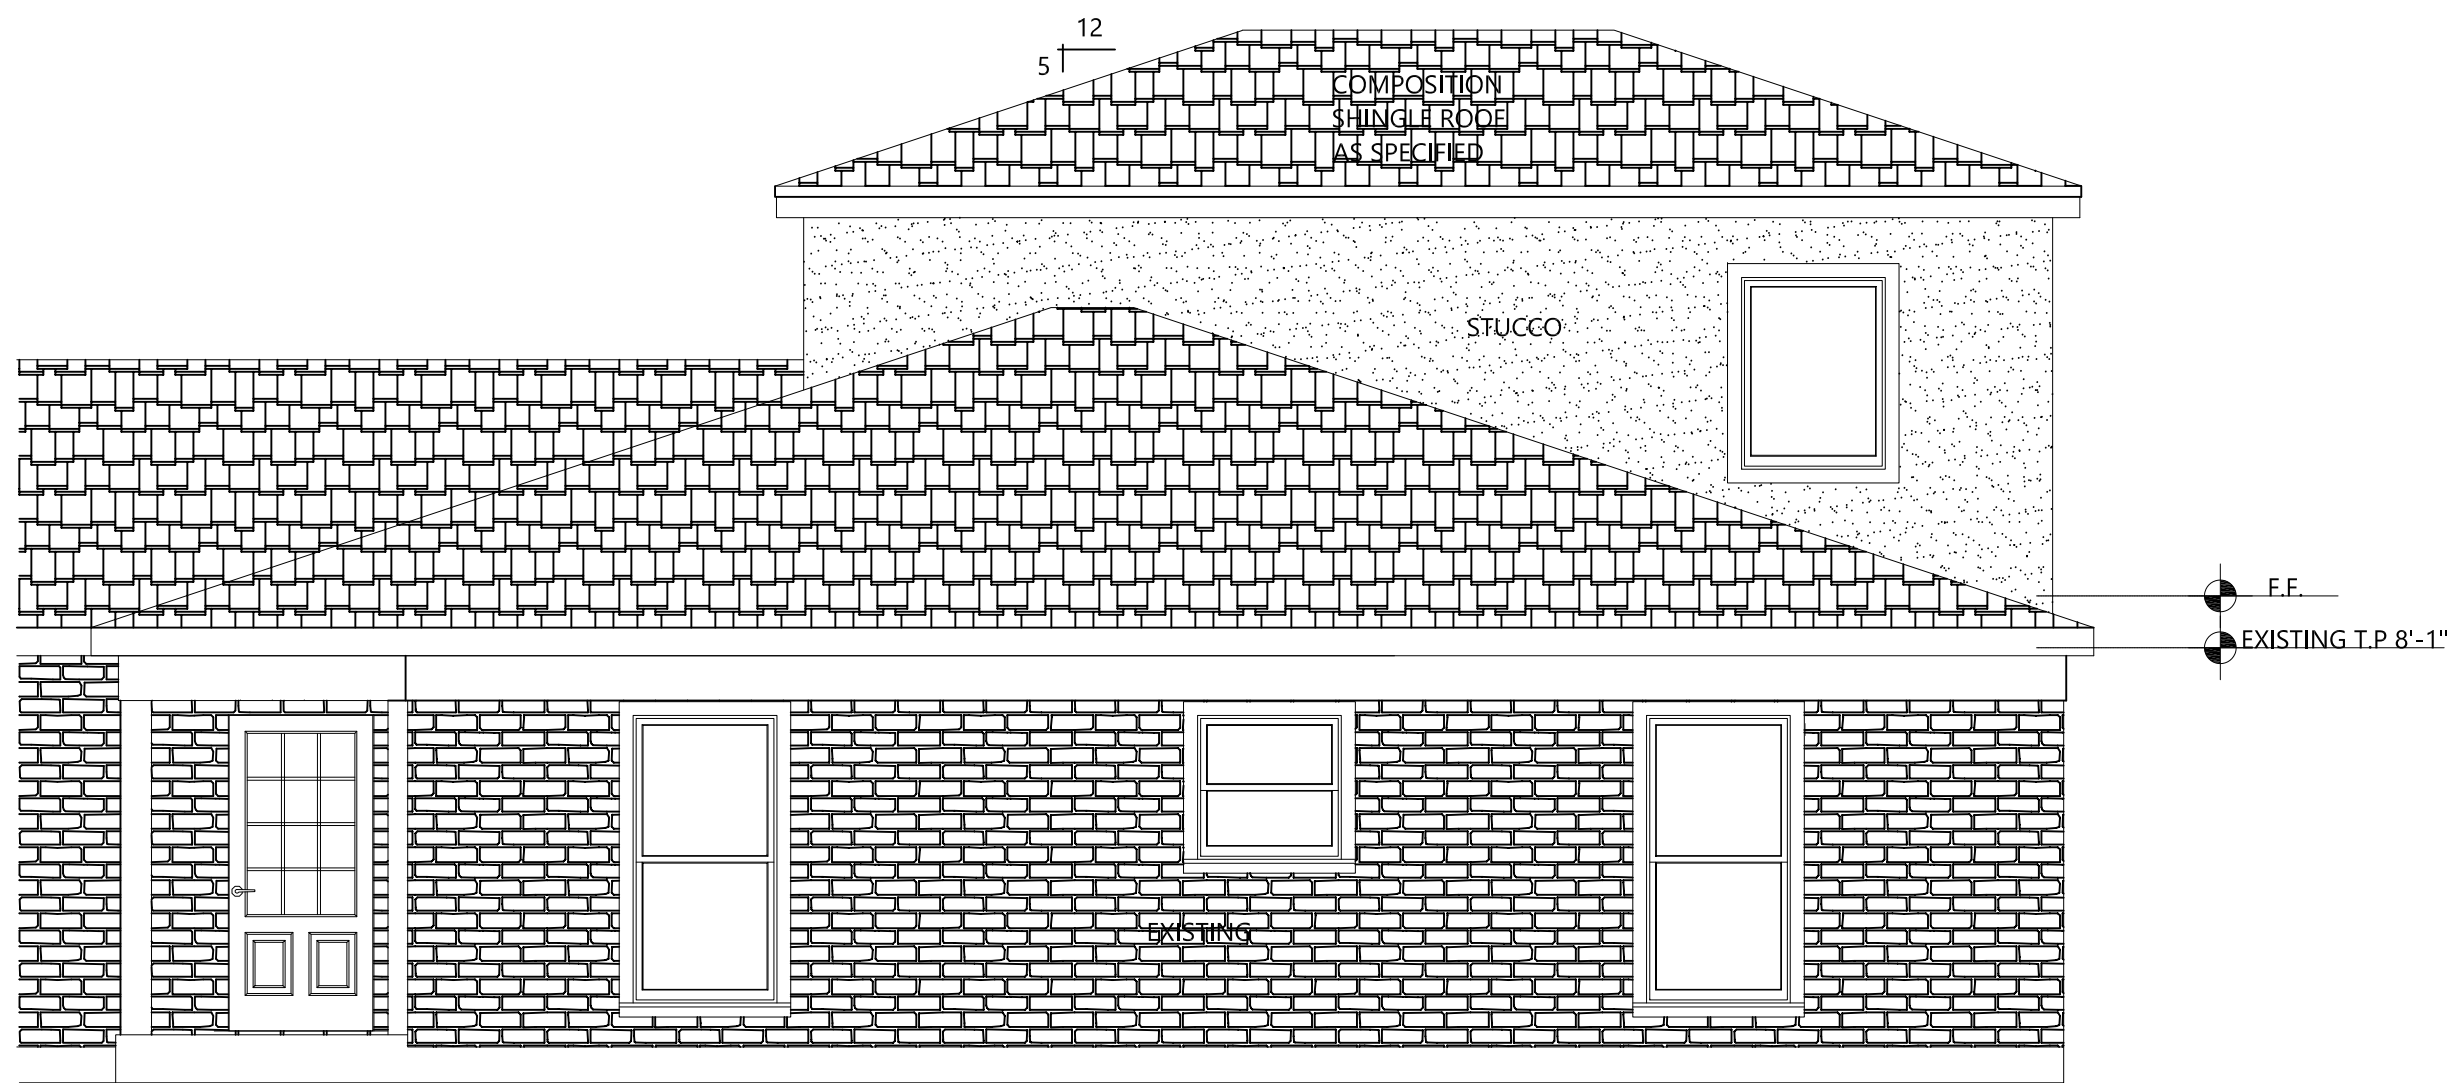


1 FRONT ELEVATION
2 SCALE 1/4"=1'-0"

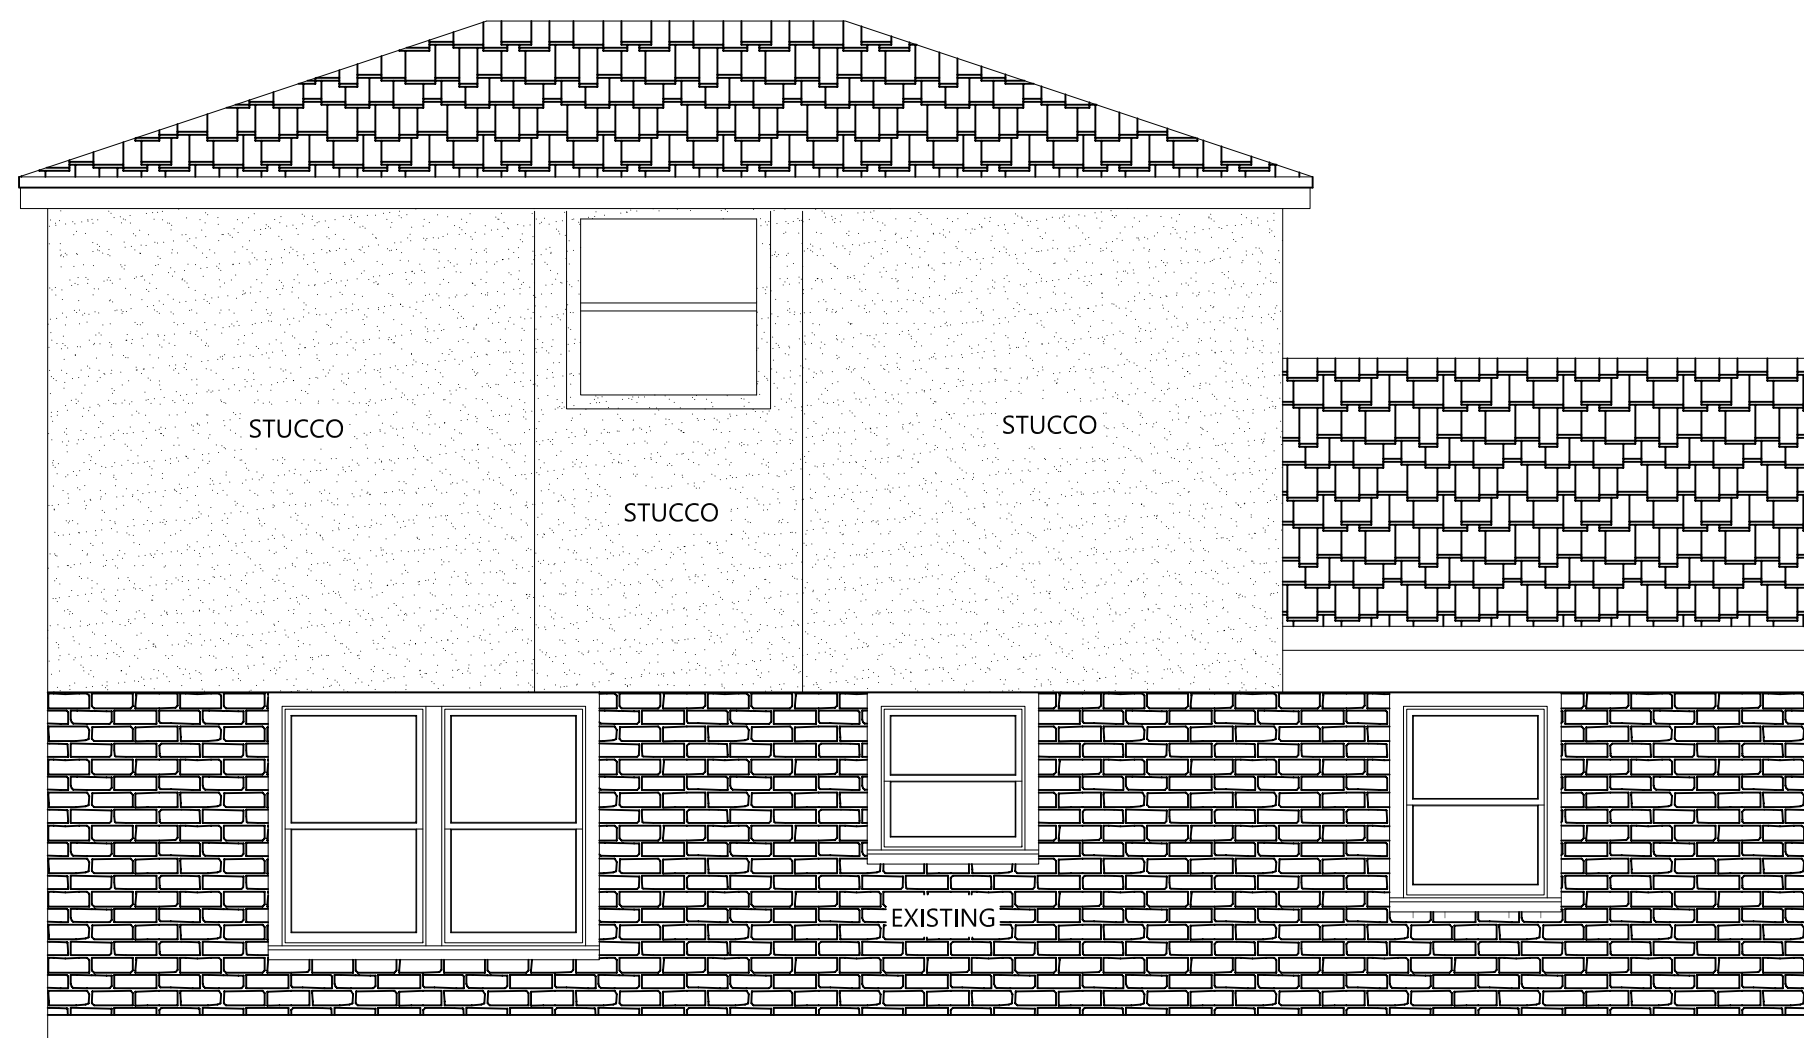

3 REAR ELEVATION
2 SCALE 1/4"=1'-0"

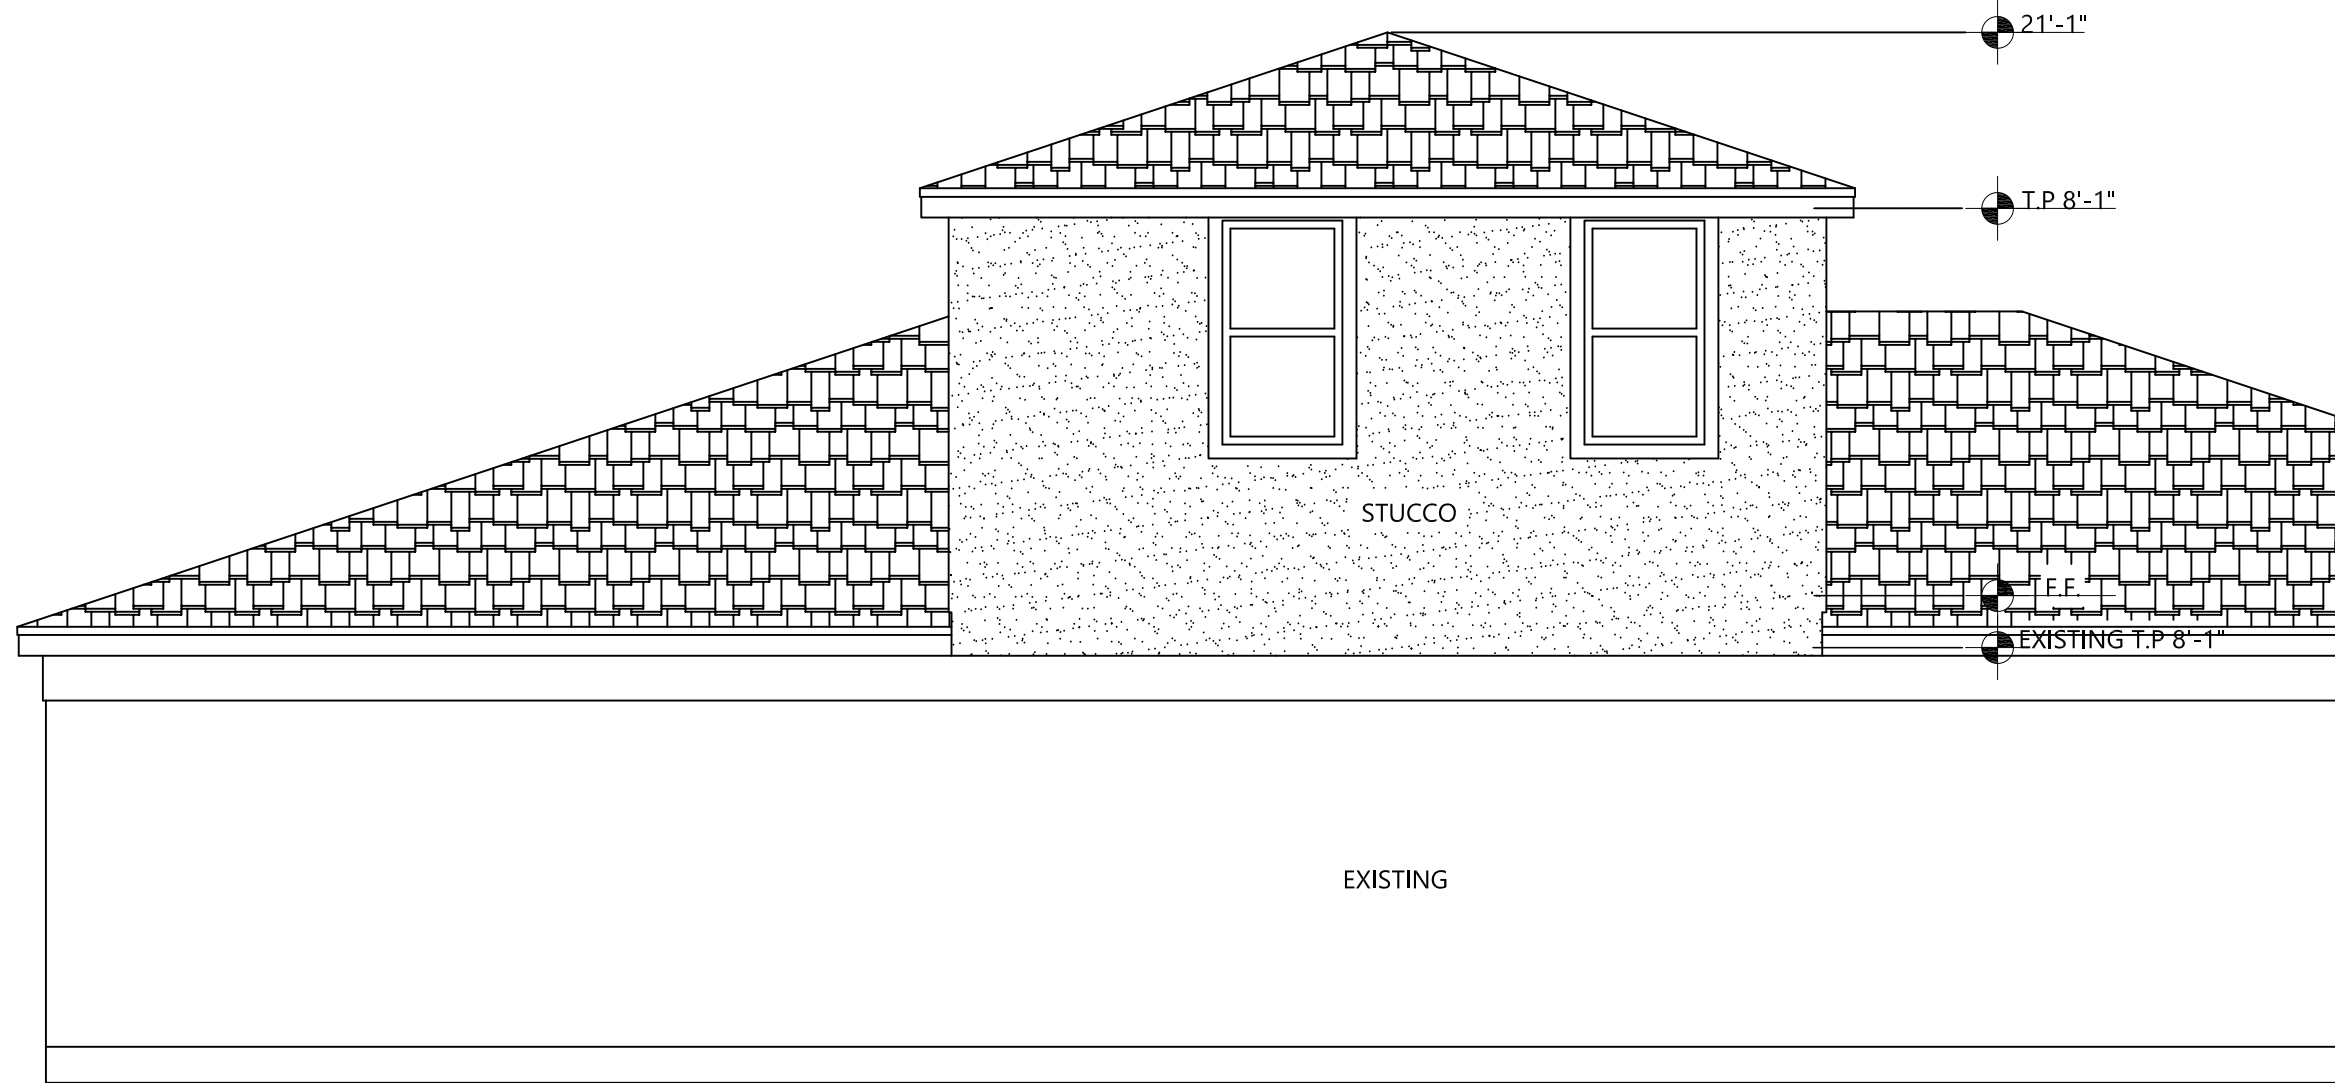


2 RIGHT ELEVATION
2 SCALE 1/4"=1'-0"

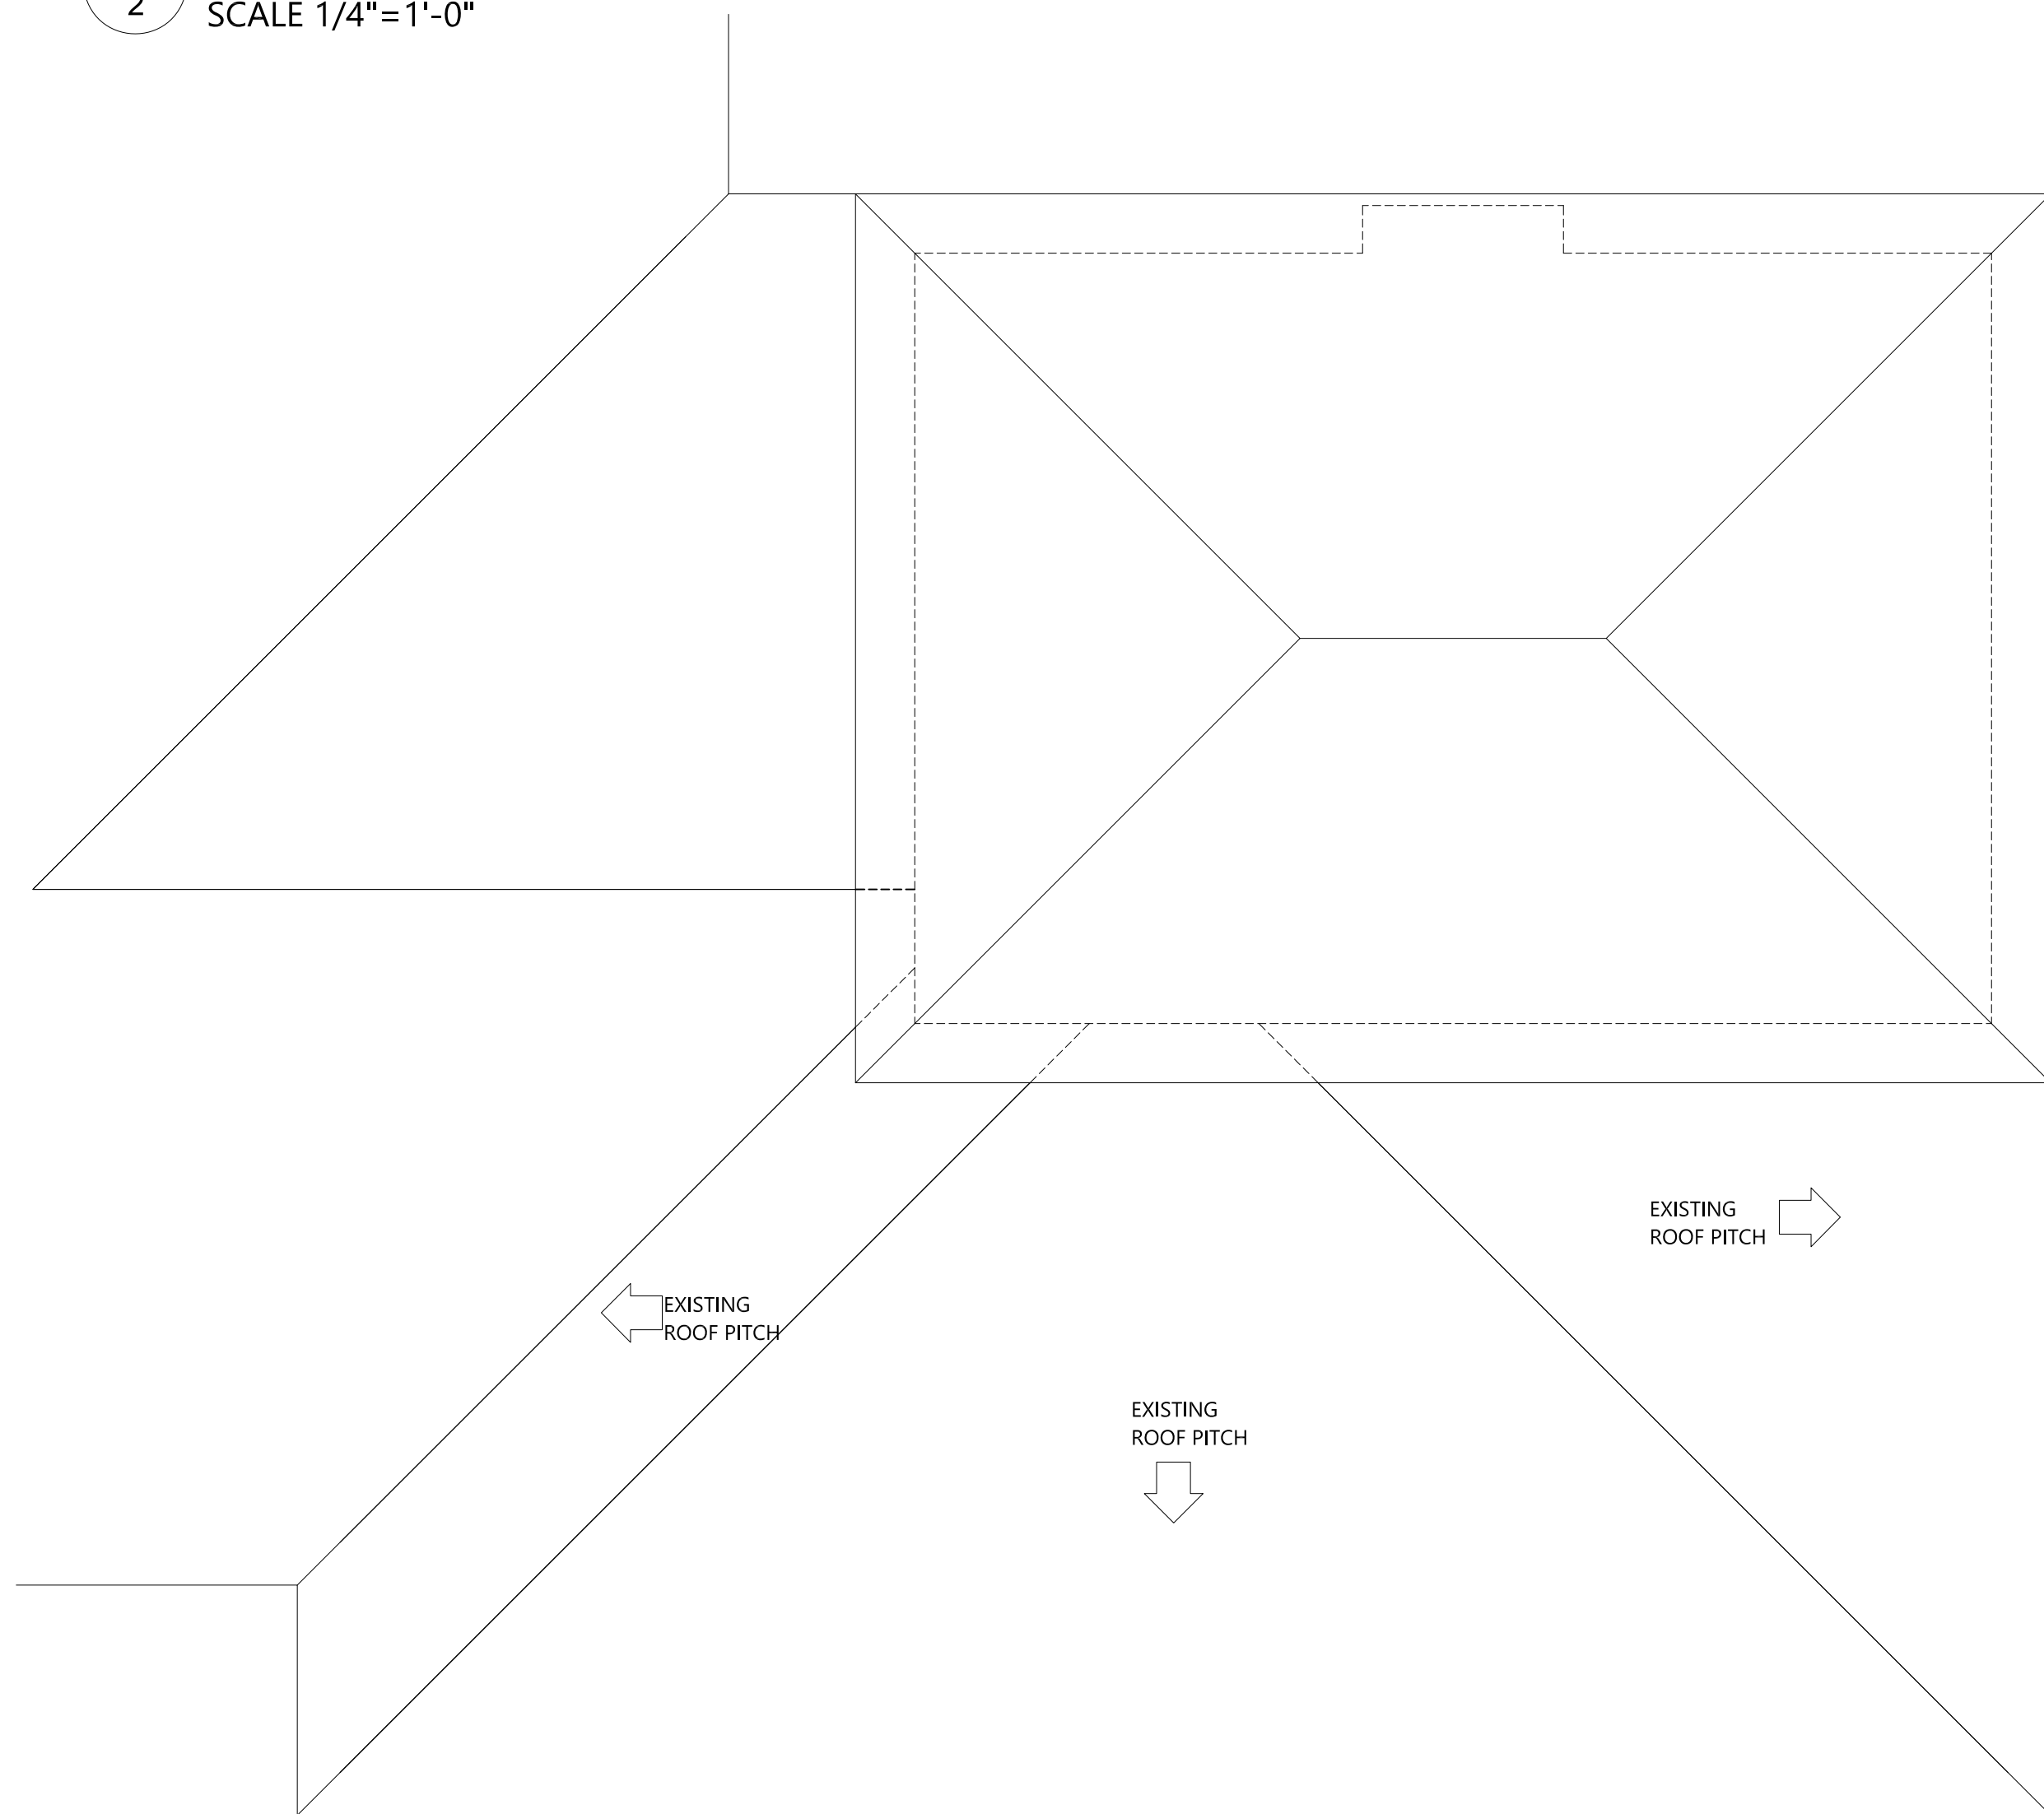


4 PROPOSED ROOF PLAN
2 Scale 1/4"=1'-0"


THIS DRAWING AND ALL INFORMATION THEREON IS THE PROPRIETARY PROPERTY OF TREND BUILDERS AND MUST NOT BE MADE PUBLIC OR COPIED. THIS DRAWING IS LOANED SUBJECT TO RETURN ON DEMAND AND IS NOT TO BE USED, DIRECTLY OR INDIRECTLY, IN ANY WAY DETRIMENTAL TO THE INTEREST OF TREND BUILDERS.	REVISIONS		DESCRIPTION
	No.	Date	
	4	00/00/00	
	3	00/00/00	
PROJECT:		2nd Floor Addition	
DRAWING:		Elevations	
CUSTOMER:			
SECURITY SCREENS IRVING TREND EST. 1992 BUILDERS, INC. REMODELING		DATE: 7/27/20	
		SHEET: 2 OF 3	

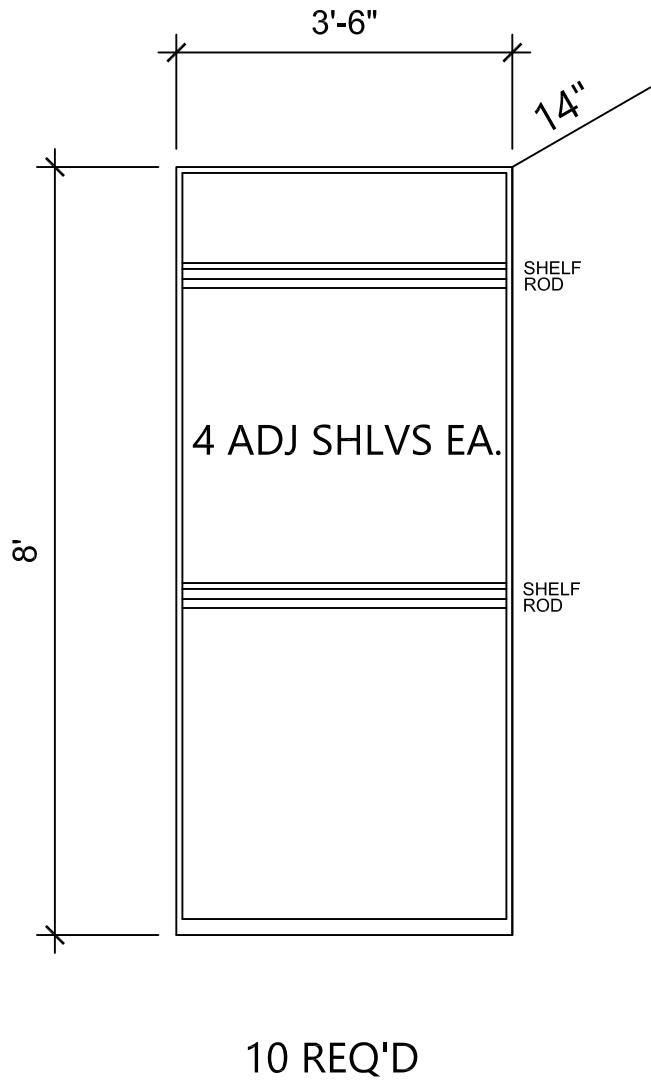


1 ELEVATION
3 SCALE 1/2"=1'-0"

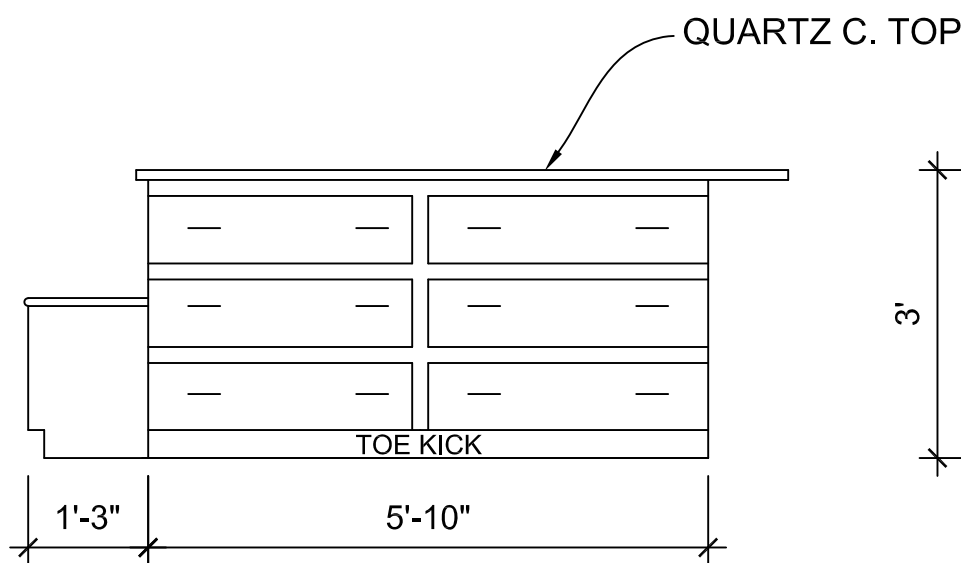

2 ELEVATION
3 SCALE 1/2"=1'-0"

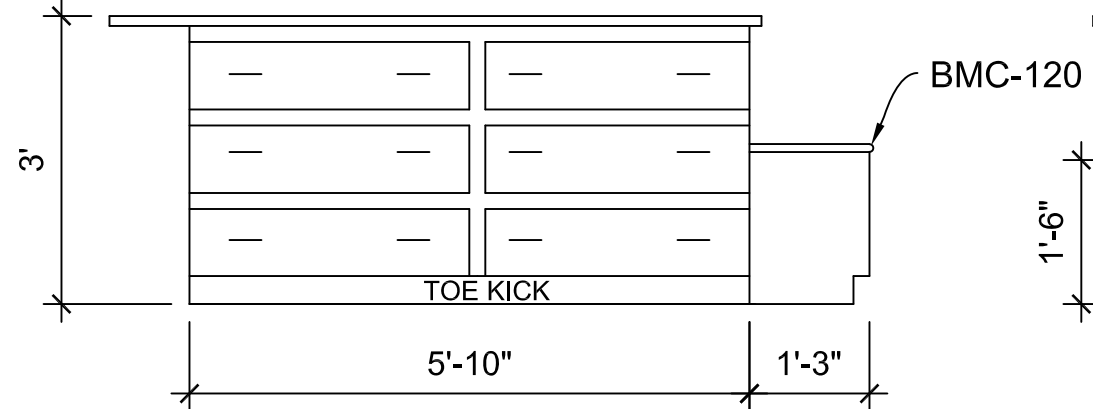

3 ELEVATION
3 SCALE 1/2"=1'-0"

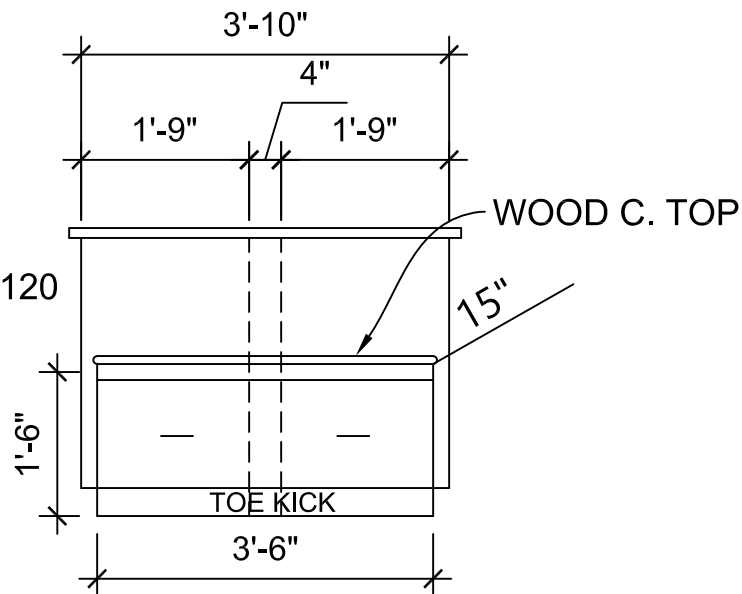

4 ELEVATION
3 SCALE 1/2"=1'-0"

CABINET SPECS.

MATERIAL : PAINT GRADE
DOORS : SHAKER
INTERIOR MAT'L : PLYWOOD
DRAWERS : PLYWOOD, FULL EXT.



DATE:
6/18/20
SHEET:
3 OF 3

CUSTOMER:
Elizabeth Ventura
515 Glen Oaks Blvd
Dallas ,Tx

PROJECT:
2nd Floor Addition
DRAWING:
Cabinet Elevations

THIS DRAWING AND ALL INFORMATION THEREON IS THE PROPRIETARY PROPERTY OF TREND BUILDERS AND MUST NOT BE MADE PUBLIC OR COPIED. THIS DRAWING IS LOANED SUBJECT TO RETURN ON DEMAND AND IS NOT TO BE USED DIRECTLY OR INDIRECTLY IN ANY WAY DETRIMENTAL TO THE INTEREST OF TREND BUILDERS.