

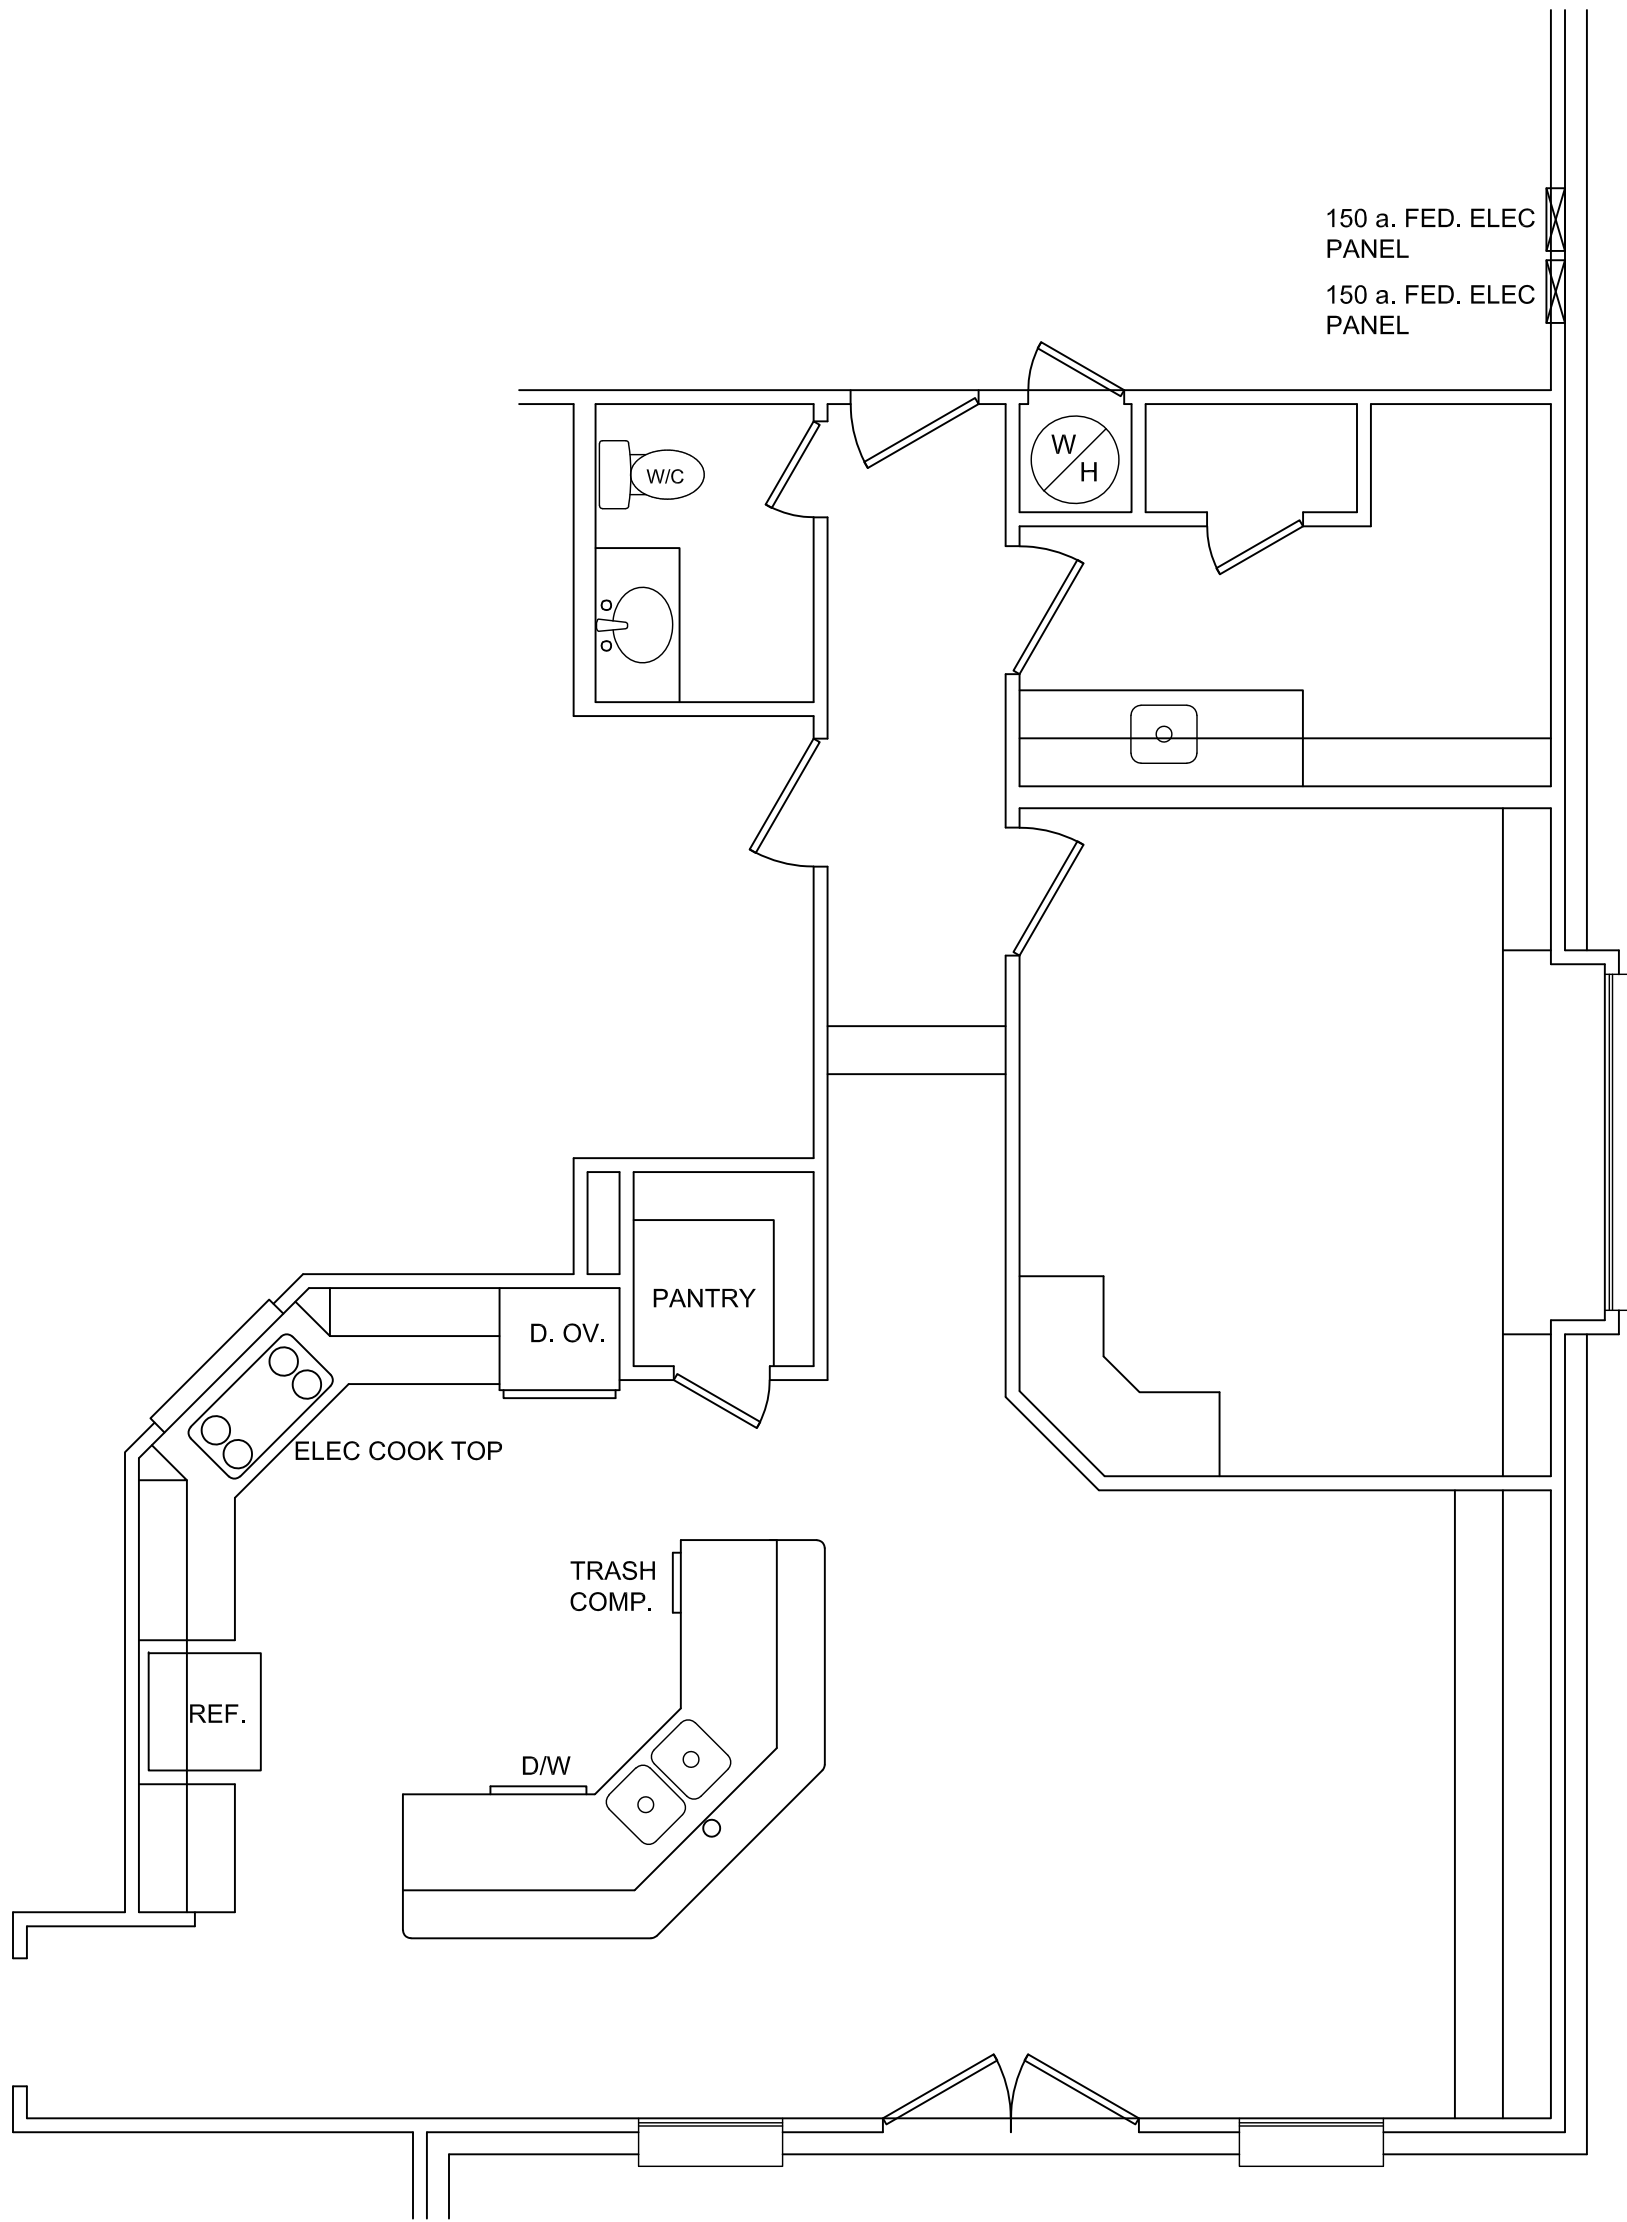


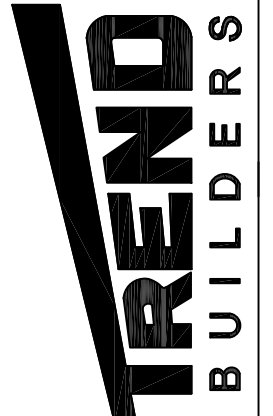

AS-BUILT FLOOR PLAN

Scale 1/4" = 1'-0"

	CUSTOMER:		PROJECT: Kitchen/Gen. Renov. DRAWING: FLOOR PLAN		REVISIONS <table><thead><tr><th>No.</th><th>Date</th><th>Description</th></tr></thead><tbody><tr><td>4</td><td>00/00/00</td><td></td></tr><tr><td>3</td><td>00/00/00</td><td></td></tr><tr><td>2</td><td>00/00/00</td><td></td></tr><tr><td>1</td><td>00/00/00</td><td></td></tr></tbody></table>	No.	Date	Description	4	00/00/00		3	00/00/00		2	00/00/00		1	00/00/00	
	No.	Date	Description																	
	4	00/00/00																		
	3	00/00/00																		
2	00/00/00																			
1	00/00/00																			
THIS DRAWING AND ALL INFORMATION THEREON IS THE PROPRIETARY PROPERTY OF TREND BUILDERS AND MUST NOT BE MADE PUBLIC OR COPIED. THIS DRAWING IS LOANED SUBJECT TO RETURN ON DEMAND AND IS NOT TO BE USED, DIRECTLY OR INDIRECTLY, IN ANY WAY DETRIMENTAL TO THE INTEREST OF TREND BUILDERS.																				
DATE: 2/4/17																				
SHEET: 1 OF 4																				

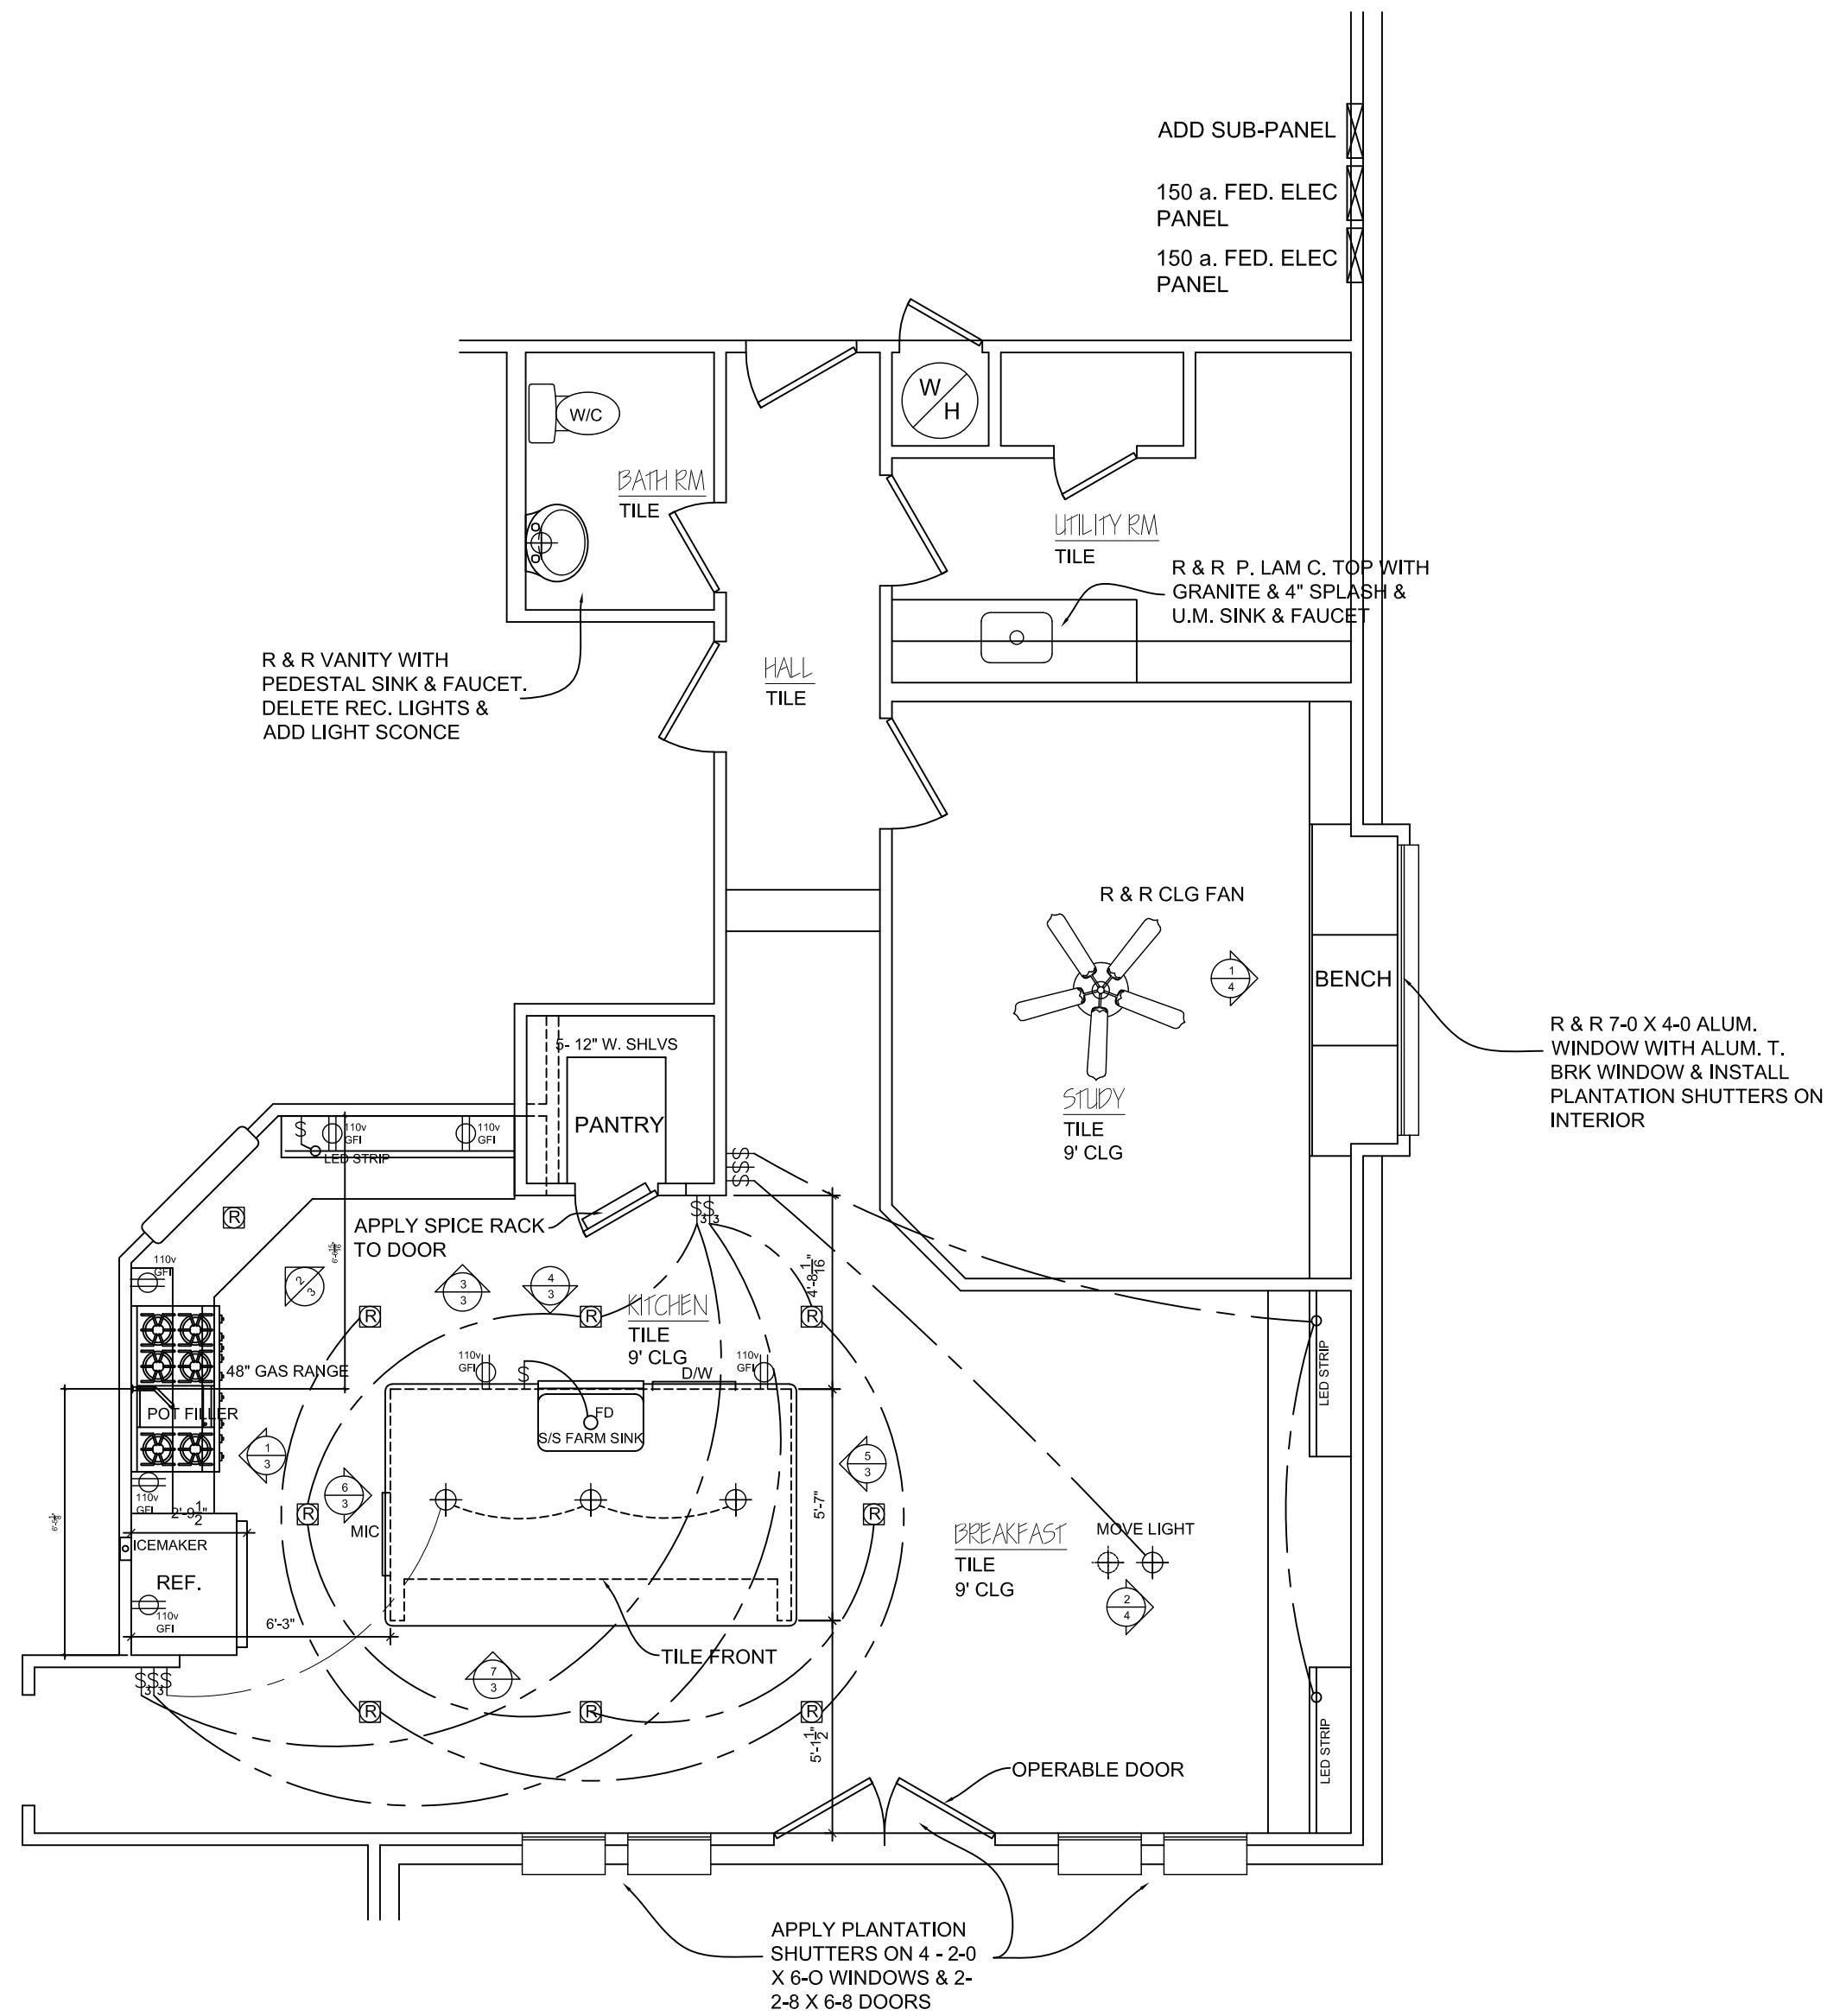

1
2

PROPOSED FLOOR PLAN

Scale 1/4" = 1'-0"

THIS DRAWING AND ALL INFORMATION THEREON IS THE PROPRIETARY PROPERTY OF TREND BUILDERS AND MUST NOT BE MADE PUBLIC OR COPIED. THIS DRAWING IS LOANED SUBJECT TO RETURN ON DEMAND AND IS NOT TO BE USED, DIRECTLY OR INDIRECTLY, IN ANY WAY DETRIMENTAL TO THE INTEREST OF TREND BUILDERS.

REV	VISIONS	Date	Description
1	4	00/00/00	
2	3	00/00/00	
3	2	00/00/00	
4	1	00/00/00	

PROJECT: Kitchen/Gen. Renov.


DRAWING: FLOOR PLAN

CUSTOMER:


TREND BUILDERS

DATE: 2/4/17


SHEET: 2 OF 4

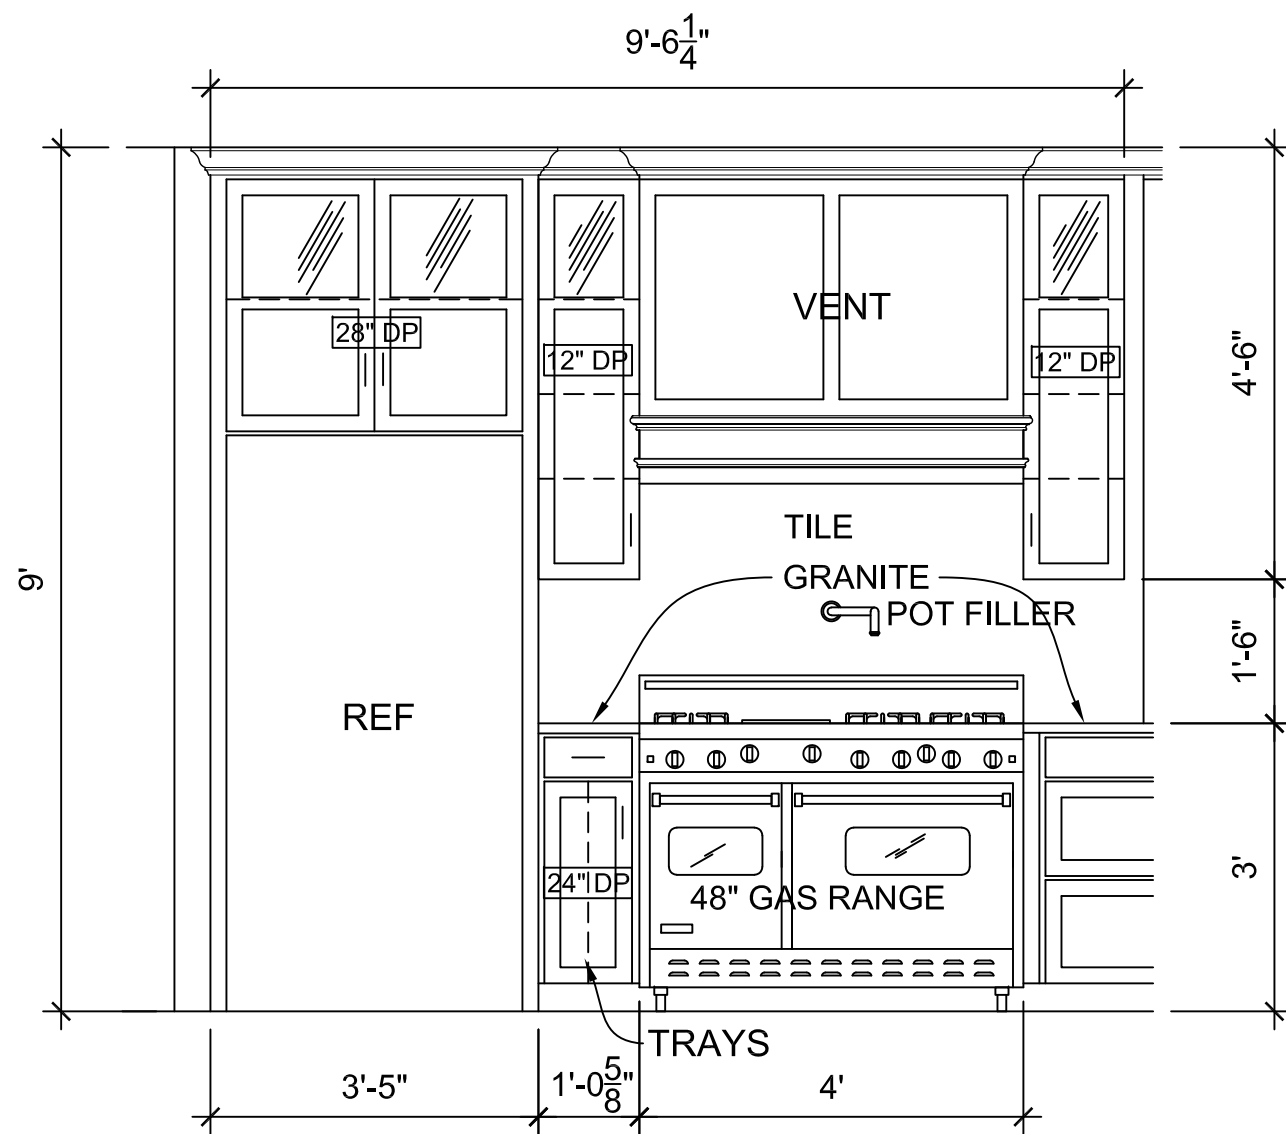



1
3 ELEVATION

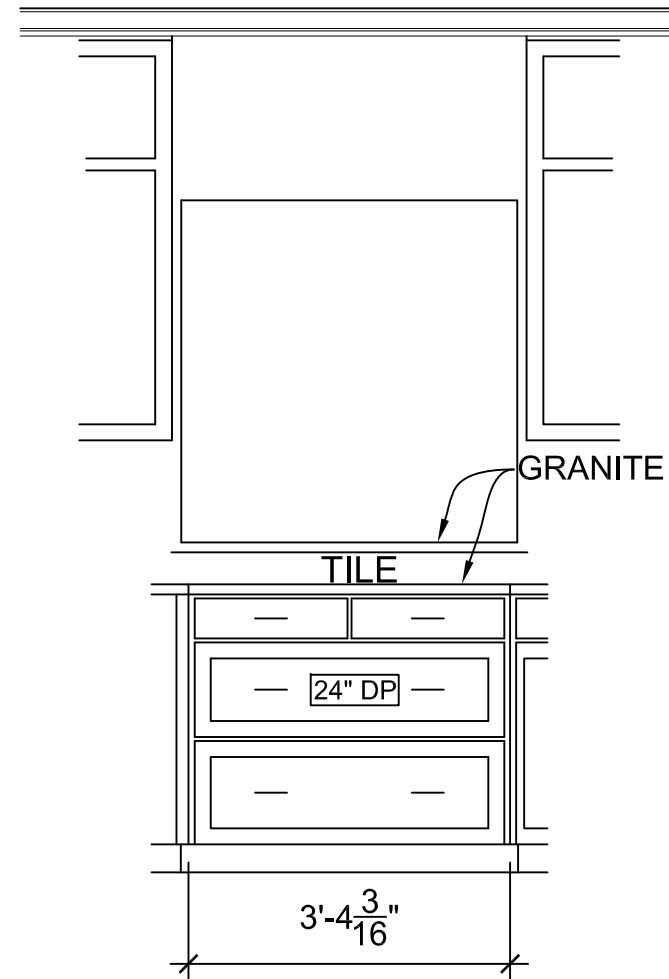


2
3 ELEVATION

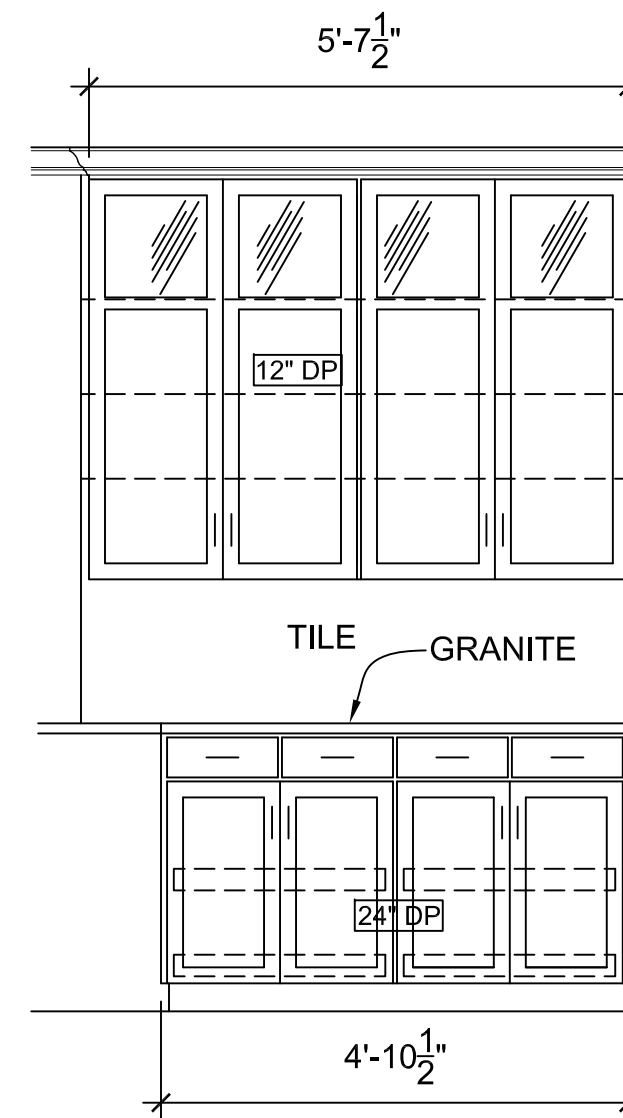


3
3 ELEVATION

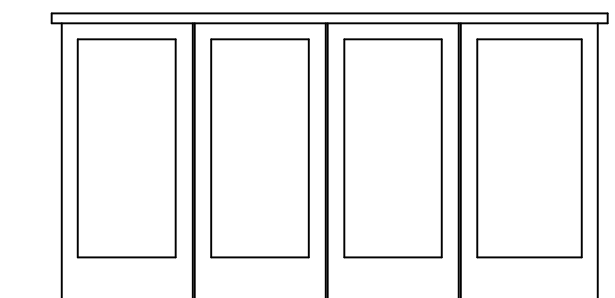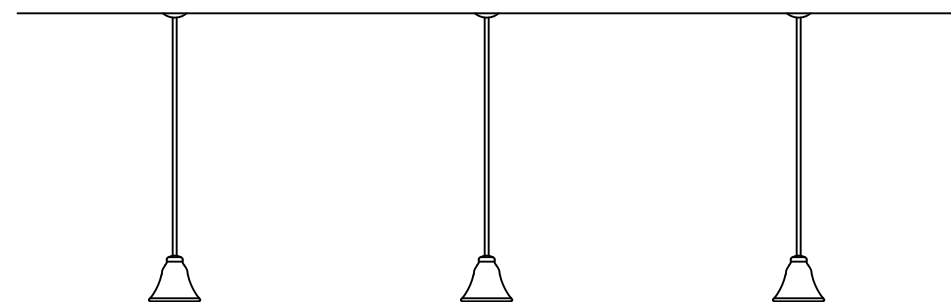

5
3 ELEVATION

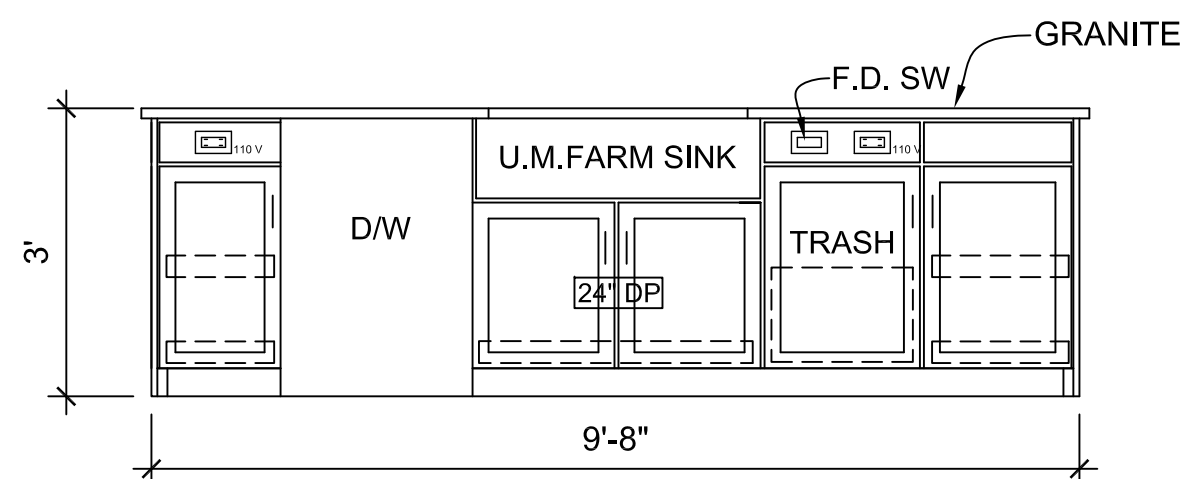

4
3 ELEVATION

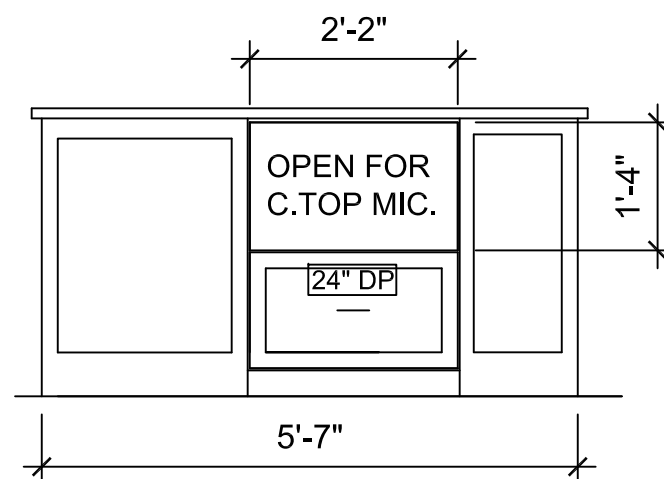


6
3 ELEVATION

SEE DETAIL SHIT FOR ISLAND

CABINET ELEVATIONS

Scale 1/2" = 1'-0"

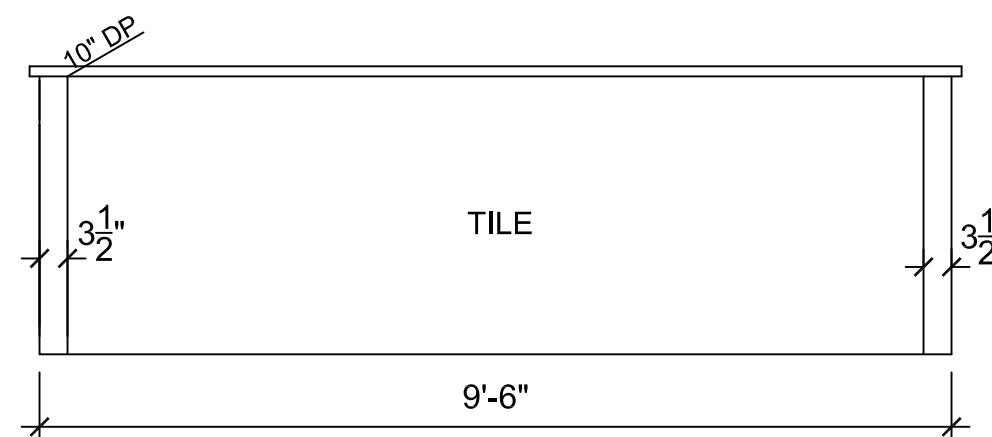

7
3 ELEVATION

CABINET SPECS.


MATERIAL : PAINT GRADE
DOORS : MITRED,FLAT PANEL
INTERIOR MAT"L : PLYWOOD
DRAWERS : PLYWOOD, FULL EXT.
1/4" REVEAL ALL DOORS & DRAWERS
MELAMINE BOTTOM IN ALL
DRAWERS

THIS DRAWING AND ALL INFORMATION THEREON IS THE PROPRIETARY PROPERTY OF TREND BUILDERS AND MUST NOT BE MADE PUBLIC OR COPIED. THIS DRAWING IS LOANED SUBJECT TO RETURN ON DEMAND AND IS NOT TO BE USED, DIRECTLY OR INDIRECTLY, IN ANY WAY DETRIMENTAL TO THE INTEREST OF TREND BUILDERS.

REVISIONS	Description
4	00/00/00
3	00/00/00
2	00/00/00
1	00/00/00

PROJECT: Kitchen/Gen.
Renov.
DRAWING: FLOOR PLAN

CUSTOMER:

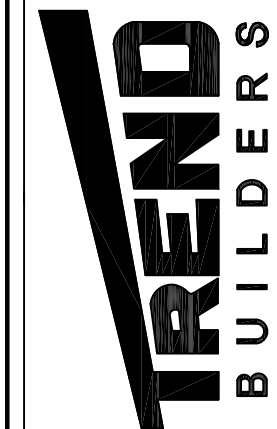

DATE: 2/4/17
SHEET: 3 OF 4



THIS DRAWING AND ALL INFORMATION THEREON IS THE PROPRIETARY PROPERTY OF TREND BUILDERS AND MUST NOT BE MADE PUBLIC OR COPIED. THIS DRAWING IS LOANED SUBJECT TO RETURN ON DEMAND AND IS NOT TO BE USED, DIRECTLY OR INDIRECTLY, IN ANY WAY DETRIMENTAL TO THE INTERESTS OF TREND BUILDERS.